


TOWN OF LEXINGTON — BOARD OF PUBLIC WORKS

WATER DIVISION

Sketch of Service Here

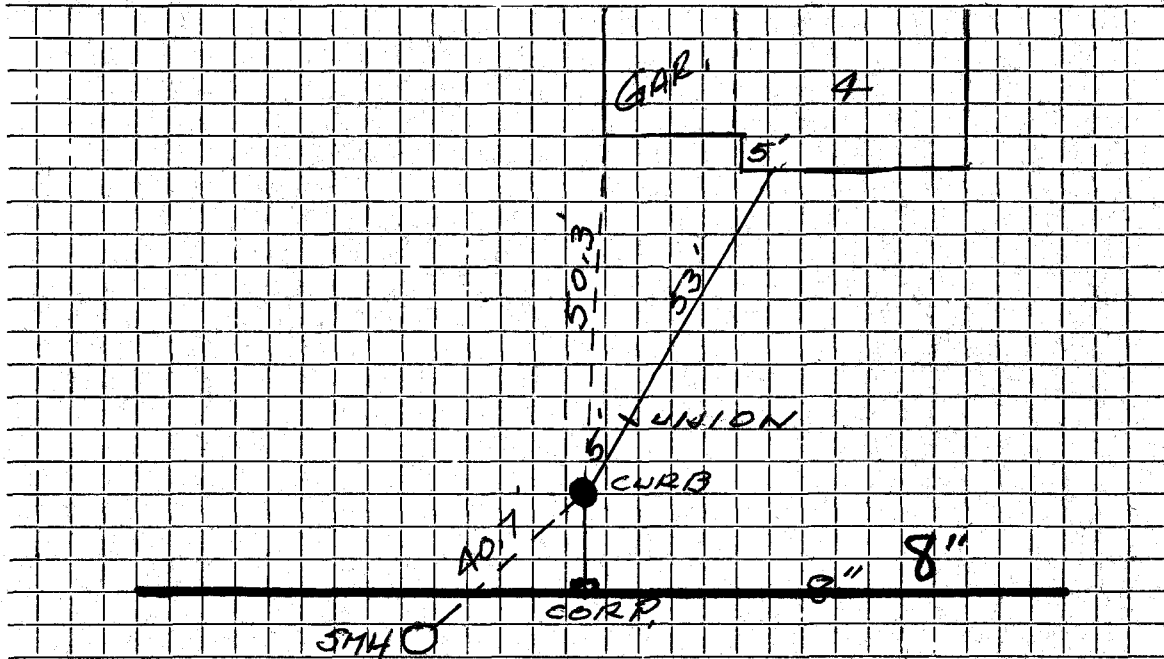

Connection made in ORCHARD LANE Street. Work completed

Remarks:

.....

.....