


DATE _____

TOWN OF LEXINGTON — BOARD OF PUBLIC WORKS

WATER DIVISION

Sketch of Service Here
Ho. # 6 & 8 LOT 16

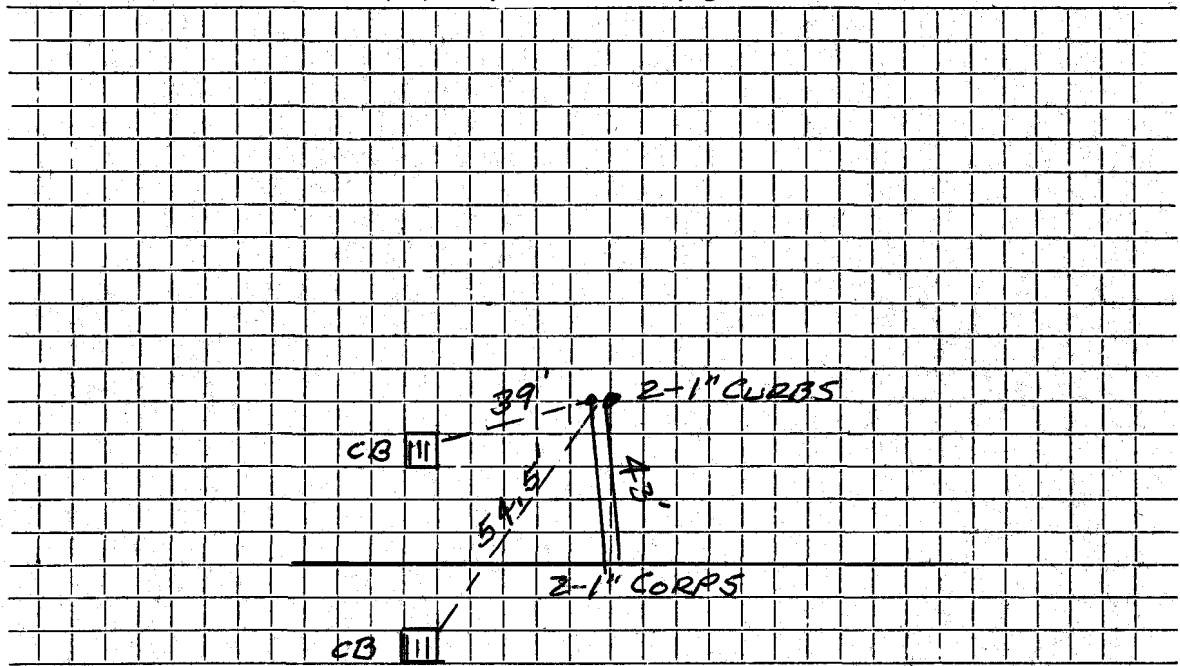

Connection made in ORCHARD LANE Street. Work completed

Remarks: 2 SERVICES FOR DUPLEX HOUSING