




TOWN OF LEXINGTON — BOARD OF PUBLIC WORKS

WATER DIVISION

Sketch of Service Here  
7 & 9 LOT 16

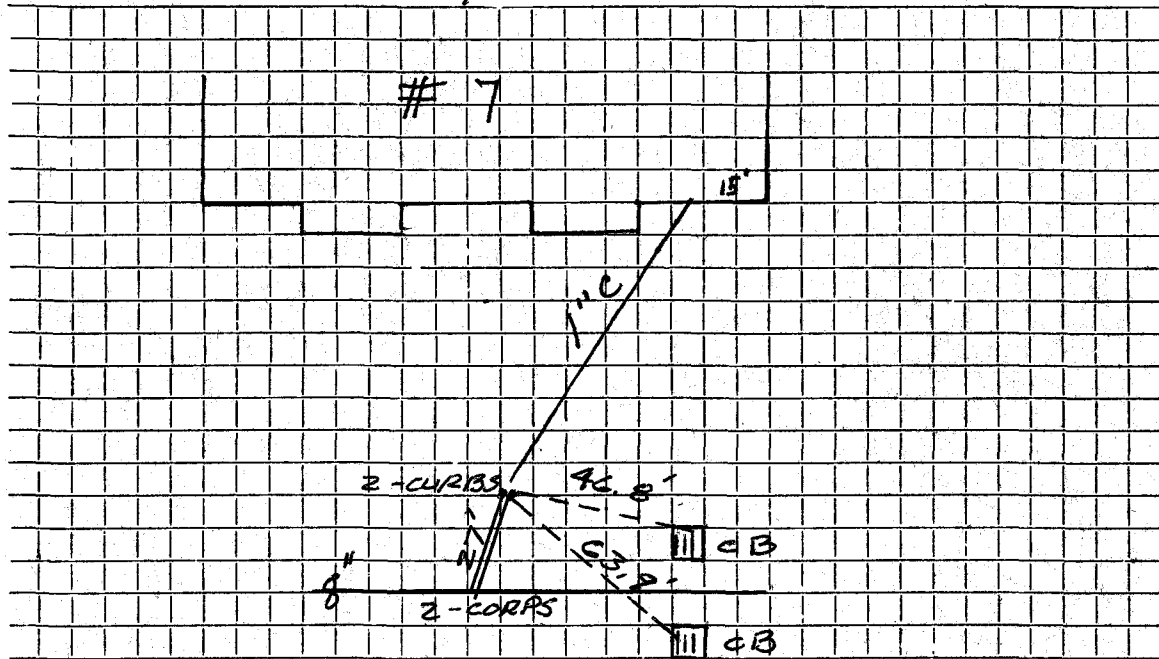

Connection made in ORCHARD LANE Street. Work completed .....

Remarks: 2-1" SERVICES FOR MULTI-DWELLING UNITS