


TOWN OF LEXINGTON — BOARD OF PUBLIC WORKS

WATER DIVISION

Sketch of Service Here
10512 LOT 16

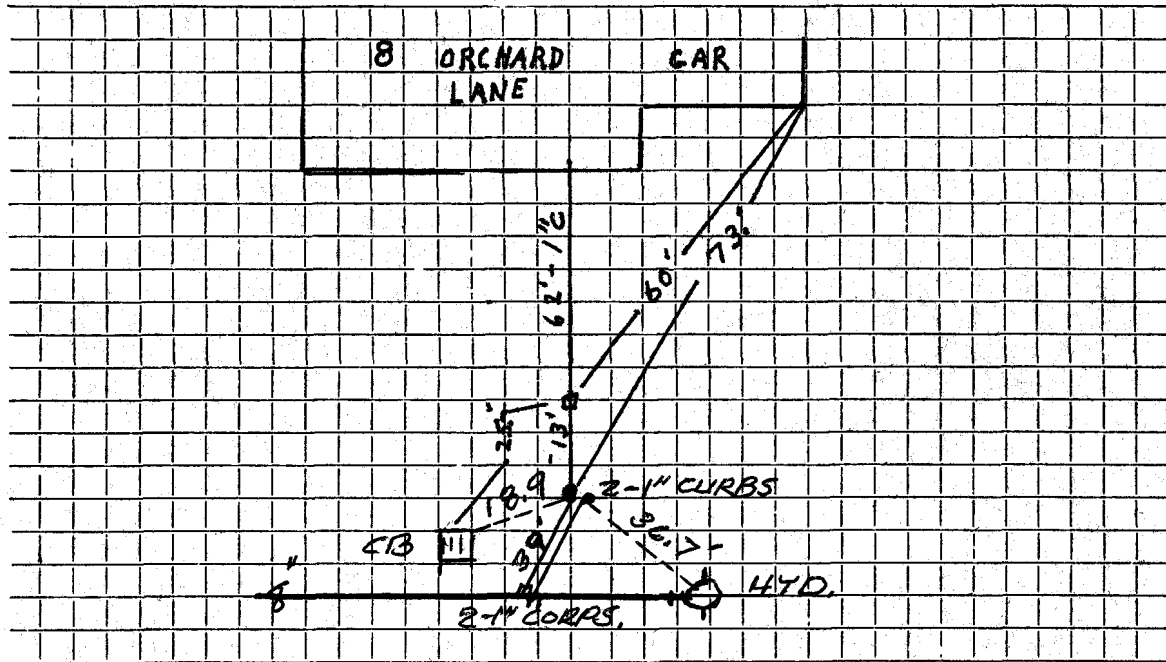

Connection made in ORCHARD LANE Street. Work completed

Remarks: 2-1" SERVICES FOR MULTIPLE DWELLING