




TOWN OF LEXINGTON — BOARD OF PUBLIC WORKS

WATER DIVISION

Sketch of Service Here

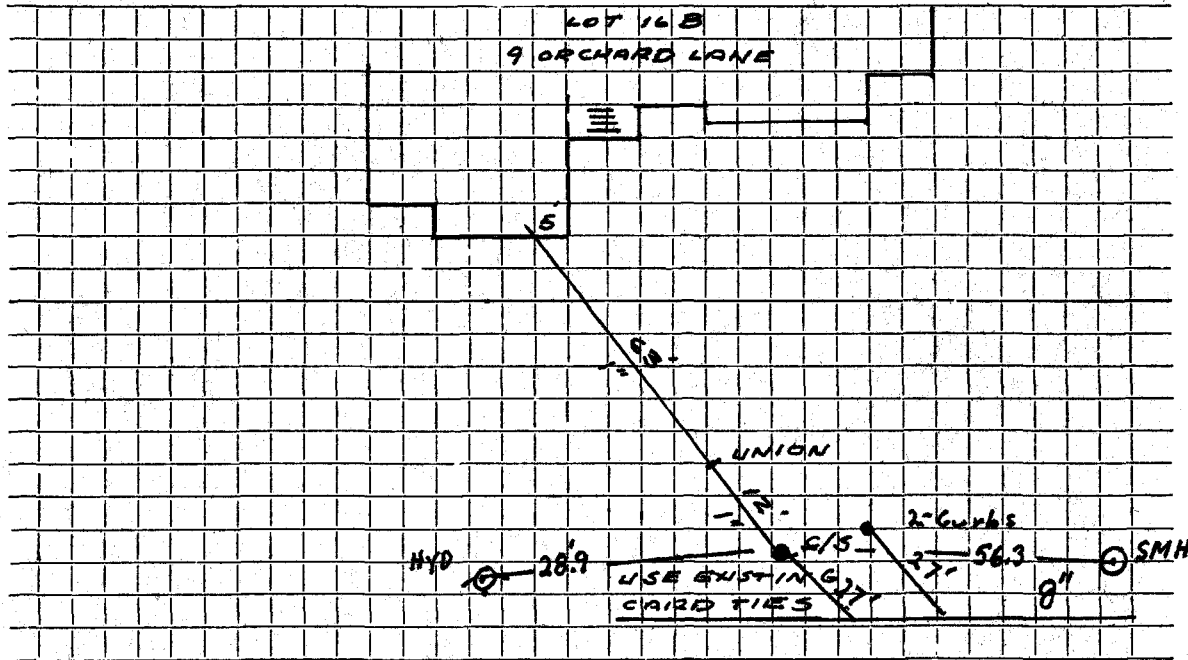

Connection made in ORCHARD LANE Street. Work completed .....

Remarks: 2-1" SERVICE FOR MULTI DWELLING UNITS. 1-NOT USED .....