

WATER SERVICE RECORD

Name Moore Realty Trust

Service No. 80

Address 103 Outlook Drive

Location Lot #36

~~XXXXXXXXXX~~ New Service

Comm 8-1-60


Date	Material	Amount	Total	Date	Amount
6-6-60	Labor	1 94		5-25-60	50 00
	10% O.H.	19	2 13	8-17-60	4 07
	108' 3/4" Copper tubing @42		45 26		56 07
	1 3/4" Cx 1/2 I.W.H. Stop&Waste		6 17		NON CHARGE
	1 3/4" C3 part Union		2 41	9-13-58	8 22
			56 07		30' 3/4" Copper tubing @.37 11 10
					1 3/4" C Corp. Cock 4 64
					1 3/4" C Curb. Cock 6 03
					1 Box & Red 5 00
					34 99
					1 1/2 Straight tailpiece 50
					1 1/2 Offset tailpiece 50
					35 99

Bill sent 8-1-60 6.07

DATE _____

TOWN OF LEXINGTON — BOARD OF PUBLIC WORKS
WATER DIVISION

Sketch of Service Here

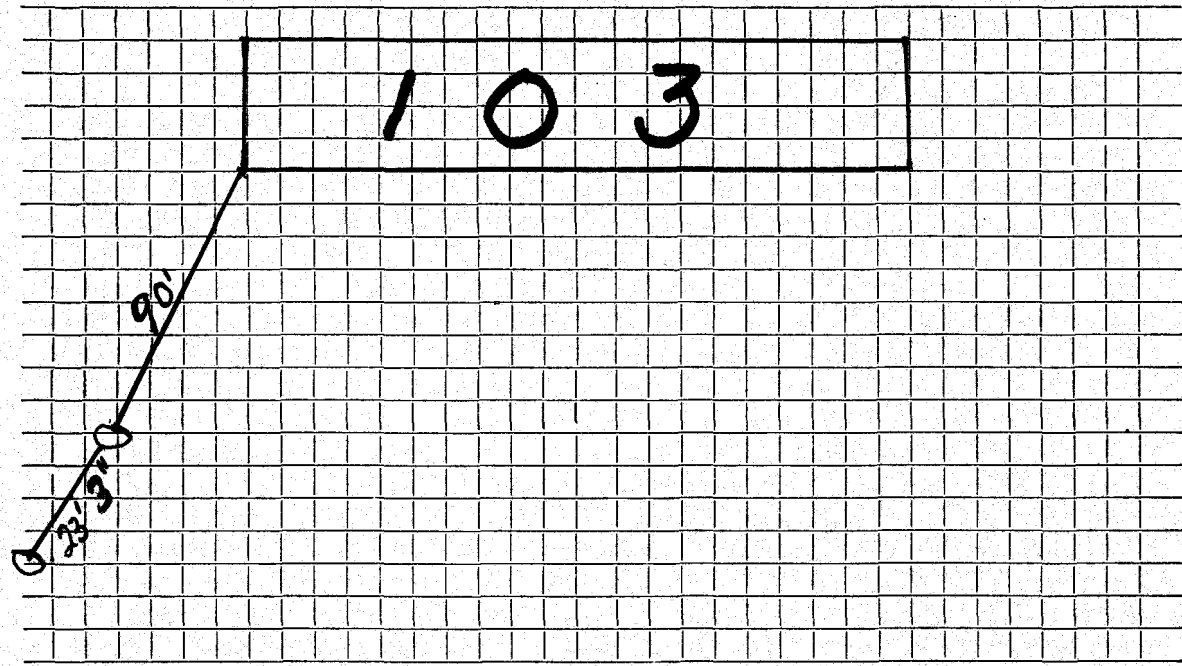

Connection made in Street. Work completed

Remarks:
.....
.....