

WATER SERVICE RECORD

Name Stephen A. Russell

Service No. 207

Address 11 Outlook Drive

Location Lexington, Mass.

REPAIRS/RENEWAL—New Service


*Cam 11-10-51*

Date	Material	Amount	Total	Date	Amount
10/1/51	Labor	1 49	1 49	8-24-51	Deposited 25 00
	10% overhead		15	11-13-51	Refunded 3 94
	45' - 3/4" copper tubing@.326	14 67	14 67		<u>NON CHARGE</u> 21 06
	1 - 3/4" Cx1/2 I.W.H.stop&waste	4 00	4 00	10/1/51	Labor 11 31
	1 hr. trucking		75	18' -3/4" copper tubing@.326	5 86
			21 06	1 -3/4" C. corp-cock	4 33
				1 - 3/4" cX 3/4" C.curb-cock	4 67
				1 box and rod	4 68
				1 -1/2 offset tail piece	50
				1 -1/2 straight tail piece	50
				4 hrs. Littlefield shovel@ 7.00	28 00
				1 hr. trucking	75
					<u>60 60</u>
				10-23-95	Connect to new main
					4'-3/4 Copper
					1-3/4 3pt union

DATE \_\_\_\_\_

TOWN OF LEXINGTON — BOARD OF PUBLIC WORKS  
WATER DIVISION

Sketch of Service Here

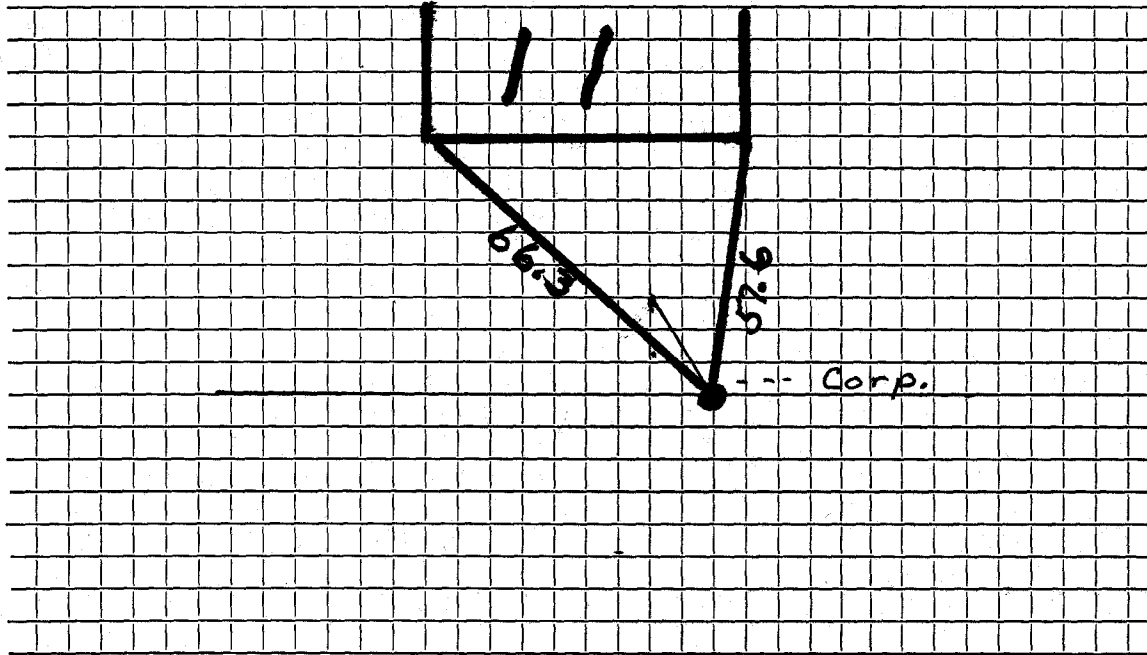

Connection made in ..... Street. Work completed .....

Remarks: 3 pt union 4' From Main .....

.....  
.....