

Name Robert Sorrentino

Service No.

279

Address 12 Outlook Drive

Lexington, Mass.

Location 12 Outlook Drive

Kind of Pipe

Size

Size of Main

~~REPAIR WORK~~ New Service

Location

| Date        | Material                         | Amount | Total | Date                           | Amount          |
|-------------|----------------------------------|--------|-------|--------------------------------|-----------------|
| Dec. 6, '48 | Labor                            | 1 15   | 1 15  | Nov. 26 '48                    | 30 00           |
|             | 10% Overhead                     |        | 12    | Dec. 31 '48                    | 8 97            |
|             | 57' - 3/4" Copper Tubing @.255   | 14 54  | 54    |                                | 21 03           |
|             | 1 - 3/4" C x 1/2" I.W.H. S&W     | 3 15   | 15    | Dec. 6, '48                    | 1 15            |
|             | 1 - 3/4" C x 3/4" C Union (3pts) | 1 32   | 32    | 13' - 3/4" Copper Tubing @.255 | 3 32            |
|             | Trucking 1 hr. @.75              | 75     | 75    | 1 - 3/4" Corp-cock             | 3 00            |
|             |                                  |        | 21 03 | 1 - 3/4" C x 3/4" C Curb-cock  | 3 68            |
|             |                                  |        |       | 1 - Box & Rod                  | 3 55            |
|             | trench dug by owner.             |        |       | 1 - 1/2" Straight Tail Piece   | 30              |
|             |                                  |        |       | 1 - 1/2" Offset Tail Piece     | 30              |
|             |                                  |        |       | Trucking 1 hr. @.75            | 75              |
|             |                                  |        |       | Connect to New Main            | 16 05           |
|             | Labor                            |        |       | 10-2395                        | 10'-3/4 Cop     |
|             |                                  |        |       |                                | 1-3/4 Comp Corp |
|             |                                  |        |       |                                | 1-3/4 Comp Curb |

TOWN OF LEXINGTON - BOARD OF PUBLIC WORKS

**WATER DIVISION**

The undersigned applies for a supply of water at No..... St. and hereby agrees to comply with the rules and regulations as now, or at any future time, established by the Board of Selectmen.

Am't of Estimate \$.....


Owner .....

Am't Paid \$.....

Address .....

Builder .....

Sketch of Service Here

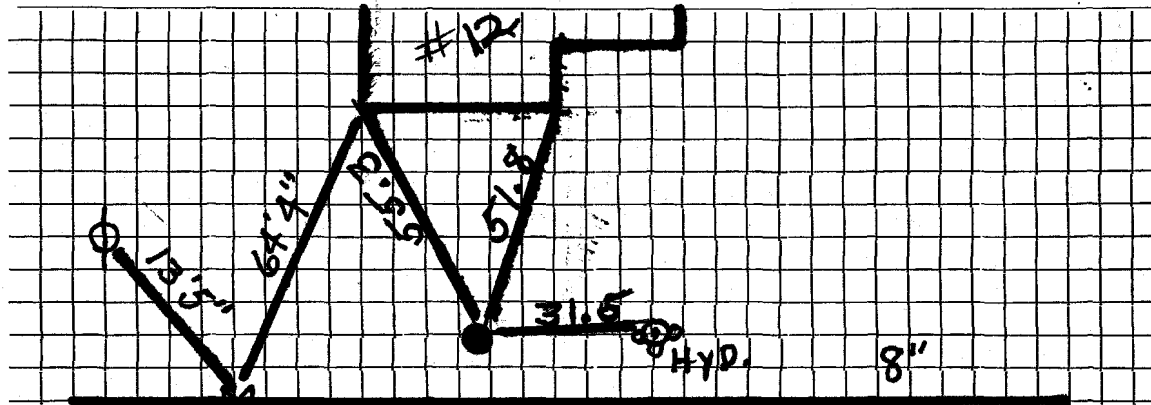

Connection made in ..... Street.

Work completed .....19

Remarks: S.M.H.