


DATE 11-2-95

TOWN OF LEXINGTON — BOARD OF PUBLIC WORKS

WATER DIVISION

Sketch of Service Here

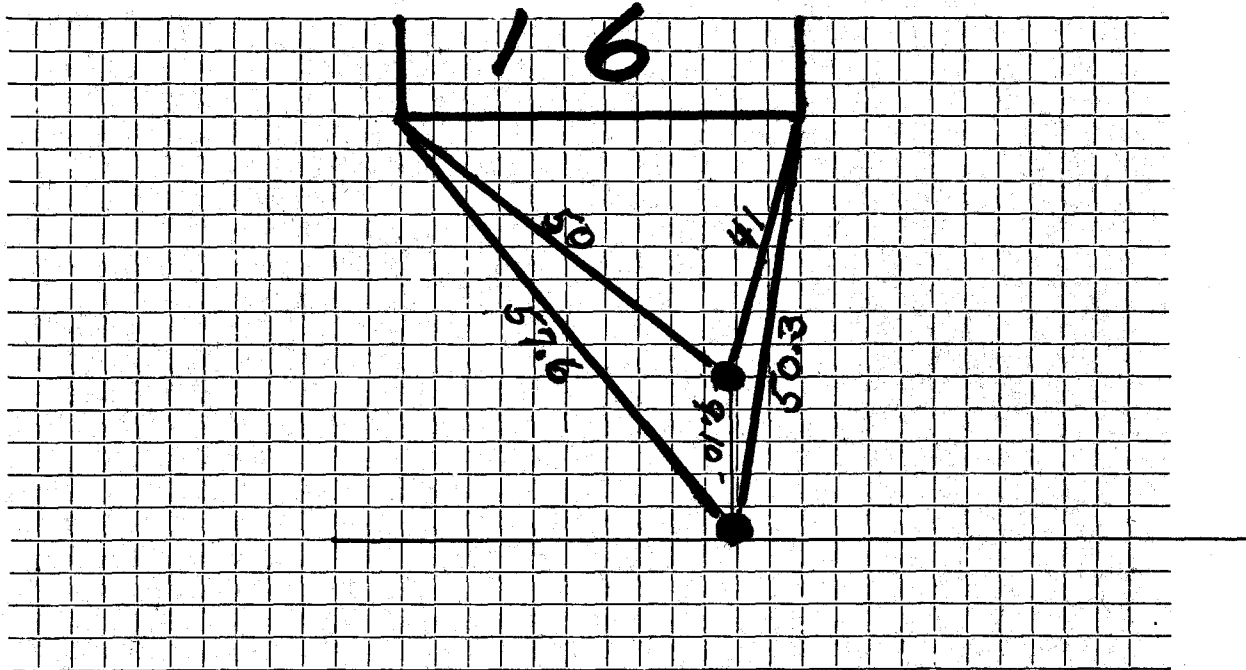

Connection made in Street. Work completed ... 10-24-95

Remarks:
.....
.....