




DATE 6-18-03

TOWN OF LEXINGTON — BOARD OF PUBLIC WORKS

WATER DIVISION

Sketch of Service Here

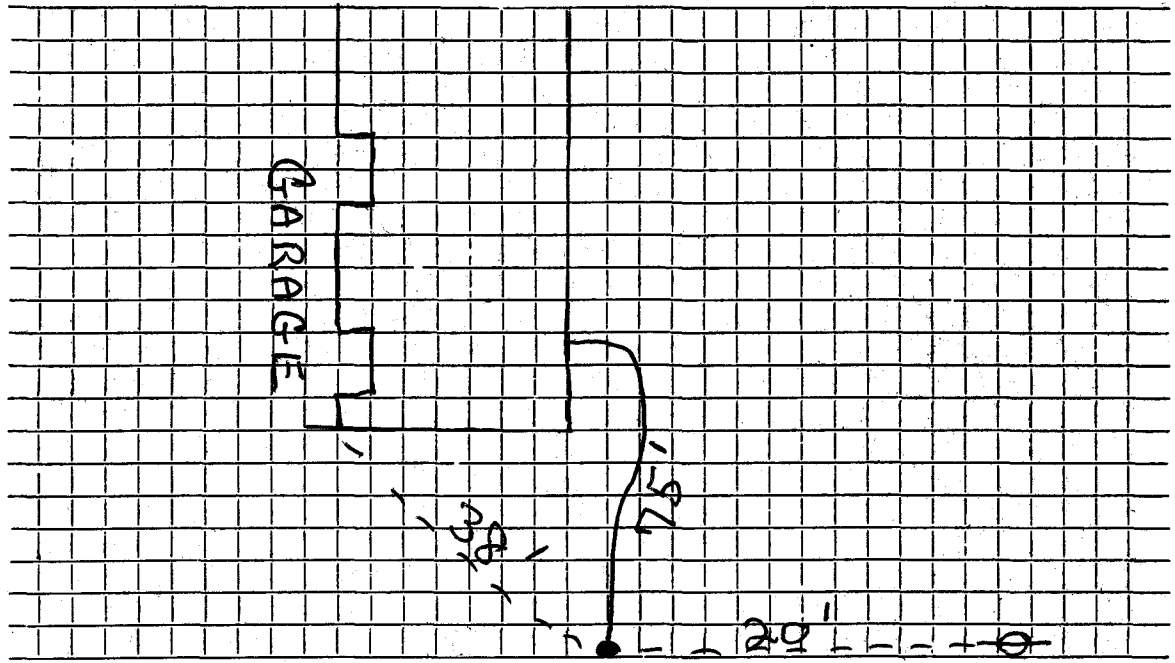

Connection made in outlook Dr. Street.

Work completed 6-18-03

Remarks: .....