

Name Albert R. Lawson

Service No. ~~##~~ 2124

Address 37 Brookside Ave., Winchester

21 Out/ode Drive

#21

Location Lot #177, Outlook Drive

Kind of Pipe

Size

Size of Main

~~Repair-Renewal~~ — New Service

Location

Date	Material	Amount	Total	Date	Amount
<i>P14-10-28 for 41.64</i>	37' 1" C.L. Pipe @ .27	9 99			
	2 1" L.L. Coup. @ .25	50		<i>Mar. 15 1928 - Cash</i>	<i>41 64</i>
	1 1" L.L. Ell	30			
	1 1" Br. Sp. Nipple	25		<i>10-25-95</i>	<i>Connect to New Main</i>
	1 S & W	3 00			<i>4'-3/4 Copper</i>
	Trucking Inside <i>3/4 Copper</i>	75	14 79		<i>1-3/4 3 pt union</i>
<i>3/19/28</i>	37 Hrs. Labor @ .55	20 35			<i>1-3/4 Corp</i>
	*3 " " @ .60	1 80			
	2 " " @ .60	1 20	23 35		
	15% Overhead		3 50		
			41 64 ✓		
	Labor				
	*-Breaking Frost				
<i>12-28-98</i>	<i>41' 1" copper</i>				

Hadley Press, Inc. Lexington

DATE _____

TOWN OF LEXINGTON - BOARD OF PUBLIC WORKS

WATER DIVISION

The undersigned applies for a supply of water at No. Lot #177 Outlook Dr. St. and hereby agrees to comply with the rules and regulations as now, or at any future time, established by the Board of Selectmen.

Am't. of Estimate \$ 45⁰⁰


Owner Albert K. Larson

Am't. Paid \$ 45⁰⁰

Address 37 Brookside Ave.
Winchester Mass.

Builder _____

Sketch of Service Here

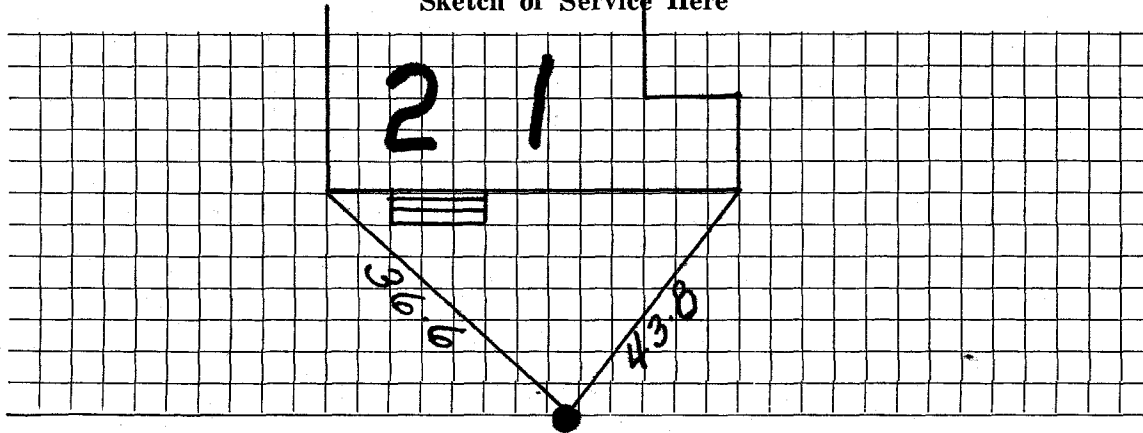

Connection made in _____ Street.

Work completed _____ 19

Remarks: