

Name Lawrence Allen

Service No. 10

Address 23 Outlook Drive

Lexington, Mass.

Location 23 Outlook Drive

Kind of Pipe Com. May 31, 1948

Size

Size of Main

~~Repair~~—Renewal—New Service

Location

Date	Material	Amount	Total	Date	Amount	
Mar. 25, '48	Labor	12 45	12 45	Mar 28 '48	Depleted	35 00
	10% Overhead		1 25	June 3 '48	Expended	8 42
	35' - 3/4" Copper Tubing @	.255	8 93			26 53
	1 - 3/4" C x 1/2" I.W.H. S & W		3 15			
	Trucking 1 hr. @ .75		75			
			26 53			
				10-25-45	Connect to New Main	
	Labor				4' - 3/4" Copper	
					1 - 3/4" Corp	
					1 - 3/4" 3pt. Union	

DATE _____

TOWN OF LEXINGTON - BOARD OF PUBLIC WORKS

WATER DIVISION

The undersigned applies for a supply of water at No..... St. and hereby agrees to comply with the rules and regulations as now, or at any future time, established by the Board of Selectmen.

Am't of Estimate \$.....

Owner


Am't Paid \$.....

Address

Builder

.....

Sketch of Service Here

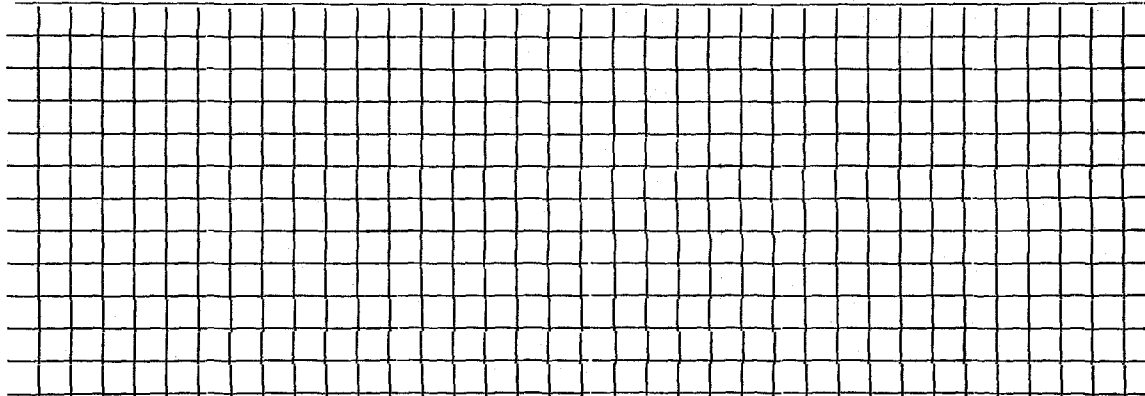

Connection made in Street.

Work completed19

Remarks: