

WATER SERVICE RECORD

Name Levi Burnell

Service No. 11

Address 25 Outlook Drive

Location

~~Repair~~ - Renewal - ~~New Service~~

Com. 4-11-55


Date	Material	Amount	Total	Date	Amount
3/10/55	Labor	1 85		1-14-55	Deposited 25 00
	10% overhead	19	2 04	4-11-55	Refunded (4 21)
	40' - 3/4" copper tubing @ .35		14 00		<u>NON CHARGE</u> 20 79
	1 - 3/4" C x 1/2 I.W.H. stop & waste		4 00	3/10/55	Labor 1 85
	1 hr. trucking		75	24' - 3/4" copper tubing @ .35	8 40
			20 79	1 - 3/4" C. corp-cock	4 33
				1 - 3/4" C. curb-cock	4 67
				1 box and rod	3 90
				1 - 1/2 offset tail pc.	50
				1 - 1/2 straight tail pc.	50
				1 hr. trucking	75
				patching 10x3	10 00
					<u>34 90</u>
					Connect to New Main
				10-26-95	1-3/4 Corp
					1-3/4 3pt union
					4' - 3/4 Copper

DATE _____

TOWN OF LEXINGTON — BOARD OF PUBLIC WORKS

WATER DIVISION

Sketch of Service Here

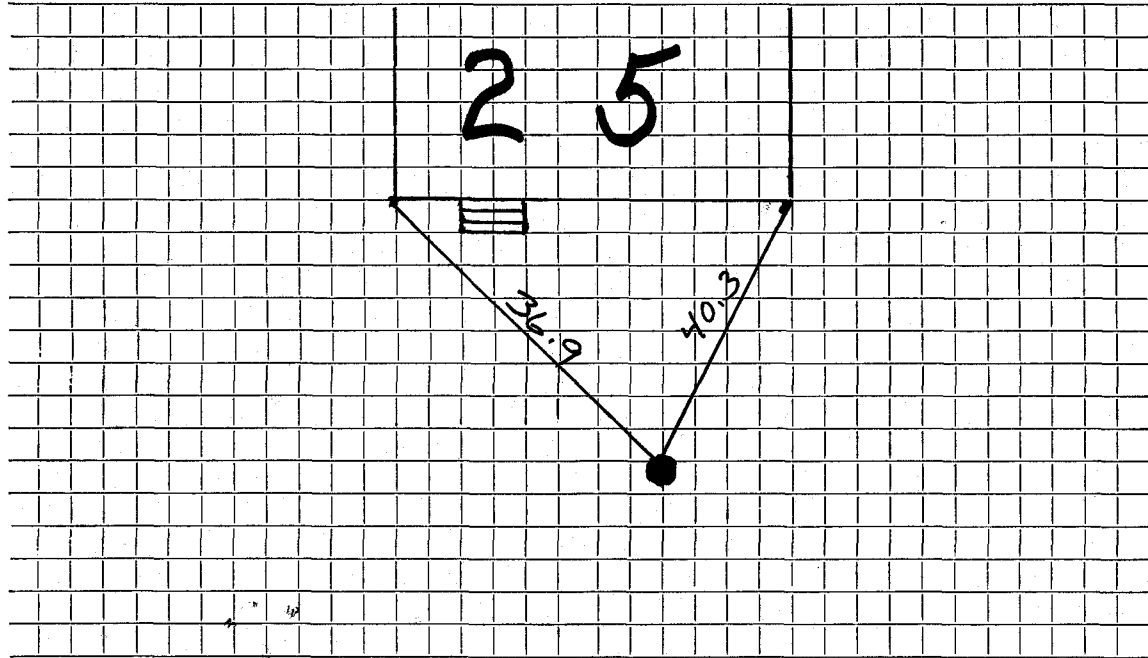

Connection made in Street. Work completed

Remarks:

.....

.....