

Check from:

Name

A. David Bjorkgren

Service No.

~~25~~ 2127

Address

265 Bedford Street, Lexington  
27 Outlook Drive

2772

Location

27 Outlook Drive

Kind of Pipe

Size

Size of Main

Repair—Renewal—New Service

Location

Date 1941	Material	Amount	Total	Date	Amount
May 10, <i>Sum 6/30/41</i>	2 hrs. @ 60¢	1 20		<i>May 8, 1941 Deposited</i>	<i>25 00</i>
	10% Overhead	12	1 32		
	40' 3/4" Copper tubing @ 19¢		7 60		
	1 3/4" C S.& W.		2 25		
	Trucking - 1 hr. @ 75¢		75		
	Trench repairs		13 08		
			25 00		
	Labor				

Hadley Press, Inc., Lexington

DATE May 5, 1947

TOWN OF LEXINGTON—BOARD OF PUBLIC WORKS  
**WATER DIVISION**

The undersigned applies for a supply of water at No. 27 Outlook Drive St. and hereby agrees to comply with the rules and regulations as now, or at any future time, established by the Board of Selectmen.

Am't. of Estimate \$ 75<sup>00</sup>

Owner

J.T. Cotty


Am't. Paid \$ \_\_\_\_\_

Address

27 outlook Drive

Builder A. David Bjorkgren  
265 Bedford St.

Sketch of Service Here

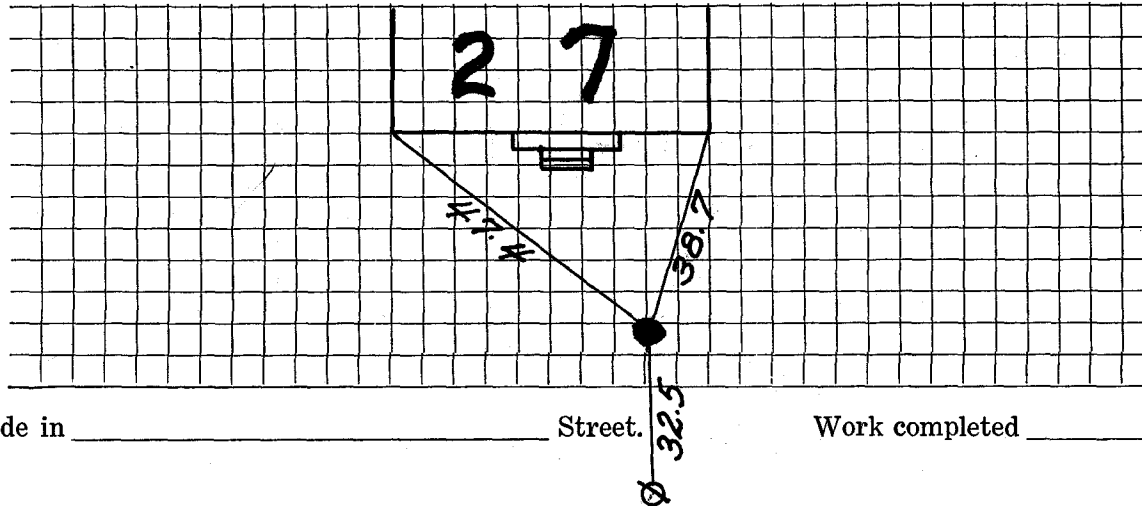

Connection made in \_\_\_\_\_ Street.

Work completed \_\_\_\_\_ 19

Remarks: