

Name **Arthur Mitchell**

Service No. 105

Address **28 Outlook Drive****Lexington**Location **28 Outlook Drive**

Kind of Pipe

Size

Size of Main

~~Repair - Renewal~~ - New Service Com. 7-3-50

Location

Date	Material	Amount	Total	Date	Amount
June 8 '50	Labor	4 58	4 58	May 23 '50	Deposited 50 00
	10% Overhead	46	46	July 20 '50	Refunded 10 00
	37' - 3/4" Copper Tubing @ 23¢	8 51	8 51		No Charge 39 59
	1 - 3/4"C x 1/2" I.W.H. S&W	3 29	3 29	June 8 '50	Labor 10 00
	2 hrs. Littlefield Shovel	14 00	14 00		14' - 3/4" Copper Tubing @ 23¢ 3 22
	1 hr. Trucking		75		1 - 3/4"C. Corp-cock 3 15
	Patching 8 x 3		8 00		1 - 3/4"C x 3/4"C Curb-cock 3 85
			39 59		1 Box & Rod 3 35
					1 - 1/2" Offset Tail Piece 38
					1 - 1/2" Straight Tail Piece 38
					1 hr. Littlefield Shovel 7 00
					1 hr. Trucking 75
	Labor				32 08

**TOWN OF LEXINGTON – BOARD OF PUBLIC WORKS**  
**WATER DIVISION**

The undersigned applies for a supply of water at No..... St. and hereby agrees to comply with the rules and regulations as now, or at any future time, established by the Board of Selectmen.

Am't of Estimate \$.....

Owner .....


Am't Paid \$.....

Address .....

Builder .....

.....

Sketch of Service Here

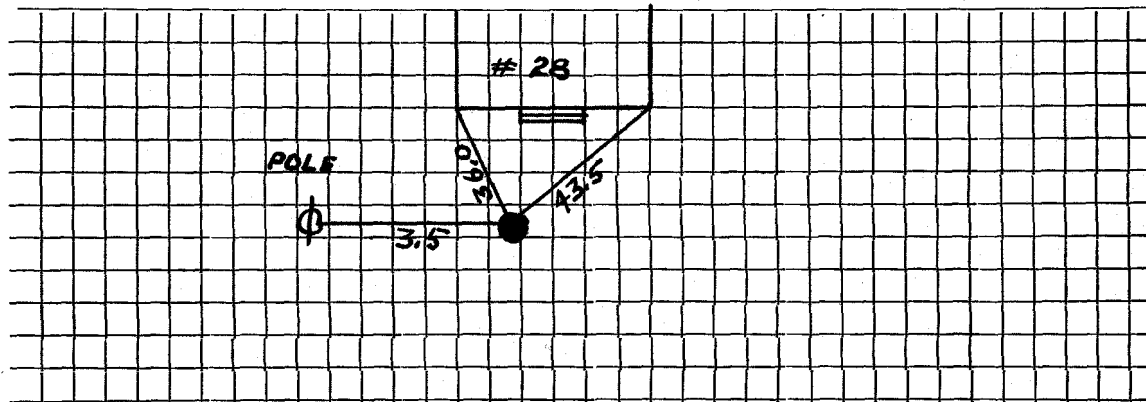

Connection made in ..... Street.

Work completed .....19

Remarks: