

WATER SERVICE RECORD

Name **Joseph Gautreau**

Service No. **12**

Address **30 A Outlook Drive**

Location

~~Repair/Replace~~ New Service **W.O.#410 Farfaras #3227**


MAY 21 1979

Date	Material	Amount	Total	Date	Remarks	Amount
5-11-79	Laborit	24.65		5-8-79	Deposit	120.00
	10% O.H.	2.47	27.12		A	Retain
	16' 3/4" Copper tubing @.74		11.84			82.85
	1 3/4" Corp		11.27			
	1 3/4" Curb		16.12		Connect to New Main	
	1 Box & Rod		13.50	10-26-95	7'- 3/4 Copper	
1	hr. Trucking @3.00		3.00		1- 3/4 Corp	
			82.85		1- 3/4 3pt union	
6-25-79	37' 3/4" Copper tubing Farfaras #3243					
<i>* Applied to S.O.# 37</i>						

DATE _____

TOWN OF LEXINGTON — BOARD OF PUBLIC WORKS
WATER DIVISION

Sketch of Service Here

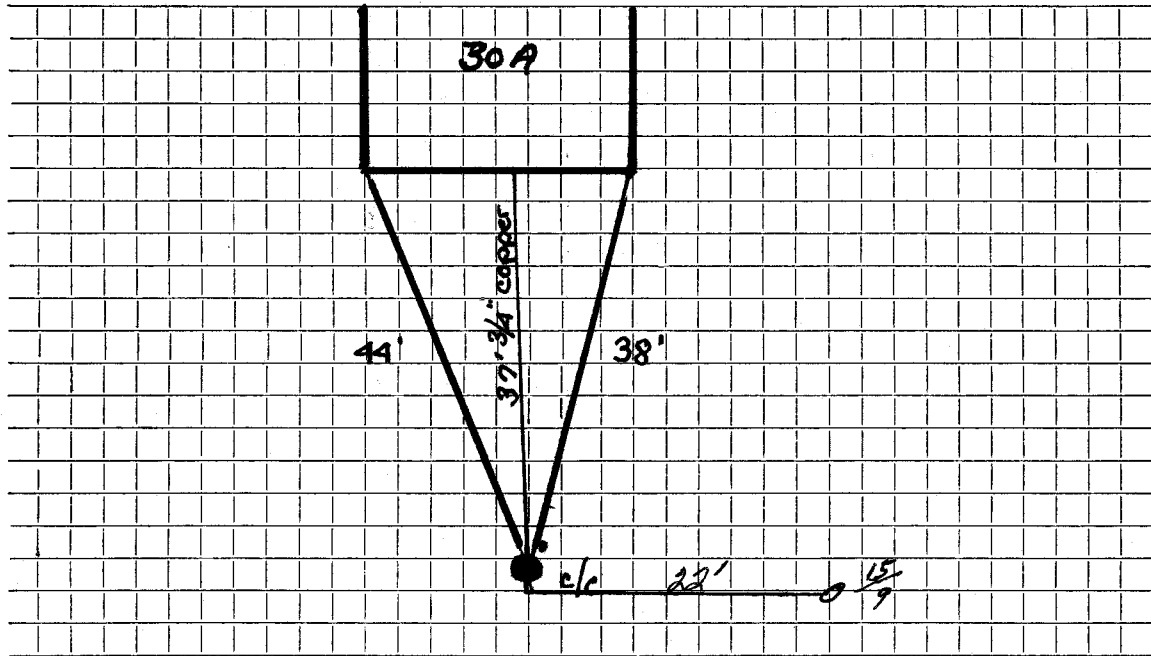

Connection made in Street. Work completed

Remarks:

.....

.....