

WATER SERVICE RECORD

Name *R.D. Petrie*

Service No. 282

Address 34 Outlook Drive, Lexington

Location

~~Repair~~ ~~Renewal~~ ~~New Service~~

*Com. 11-21-55*


Date	Material	Amount	Total	Date	Amount
9/1/55	Labor	1 85		8-24-55	Deposited 25
	10% Overhead	19	2 04	11-21-55	Refunded 4
	37'-3/4" Copper tubing @.384	14 21			Non Charge 20
	1-3/4" Cx 1/2" I.W.H. stop & waste	4 00	20 25	9/1/55	1-1/2" straight tail piece
					1-1/2" offset tail piece
				9-2-52	
					<del>12' 3/4" Copper</del>
					<del>1 3/4" C. Corp Adapter</del>
					<del>1 3/4" C. X 3/4" C. Curb Cock</del>
				OCT 2002	8' 1" COPPER
					1" Corp
					1" Curb
					Bufflo box
					1" X 3/4" Red

DATE \_\_\_\_\_

TOWN OF LEXINGTON — BOARD OF PUBLIC WORKS

**WATER DIVISION**

Sketch of Service Here

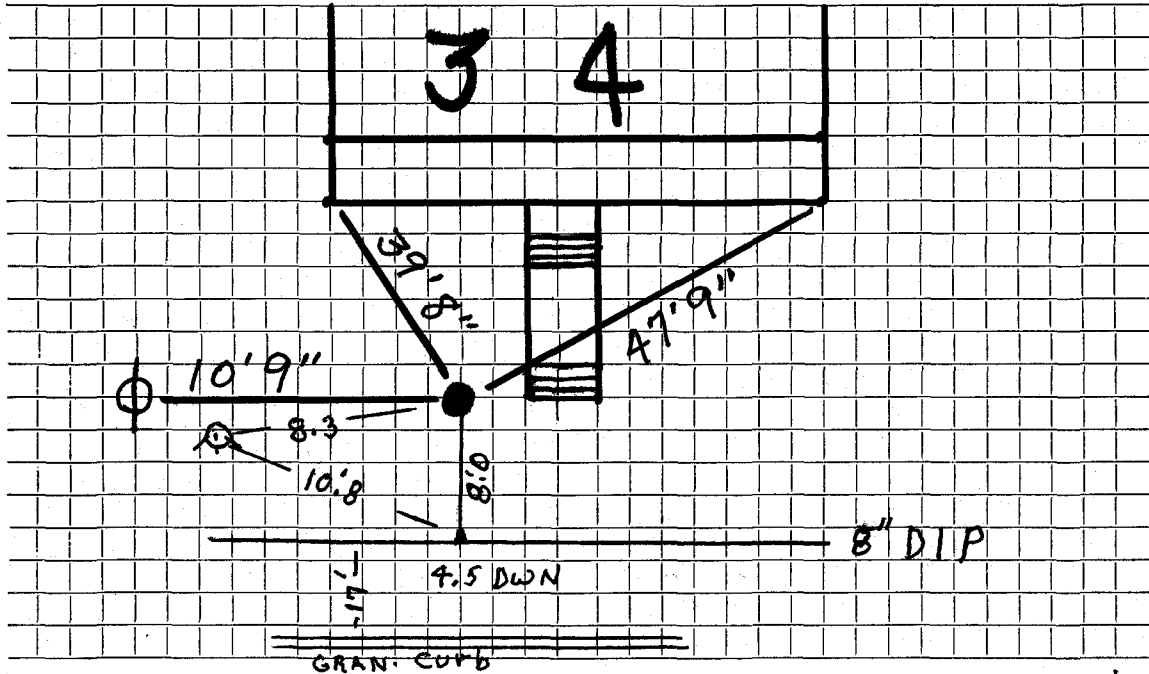

Connection made in ..... Street. Work completed 2002 Demi .....

Remarks: .....