


TOWN OF LEXINGTON — BOARD OF PUBLIC WORKS

WATER DIVISION

Sketch of Service Here
outlook DR

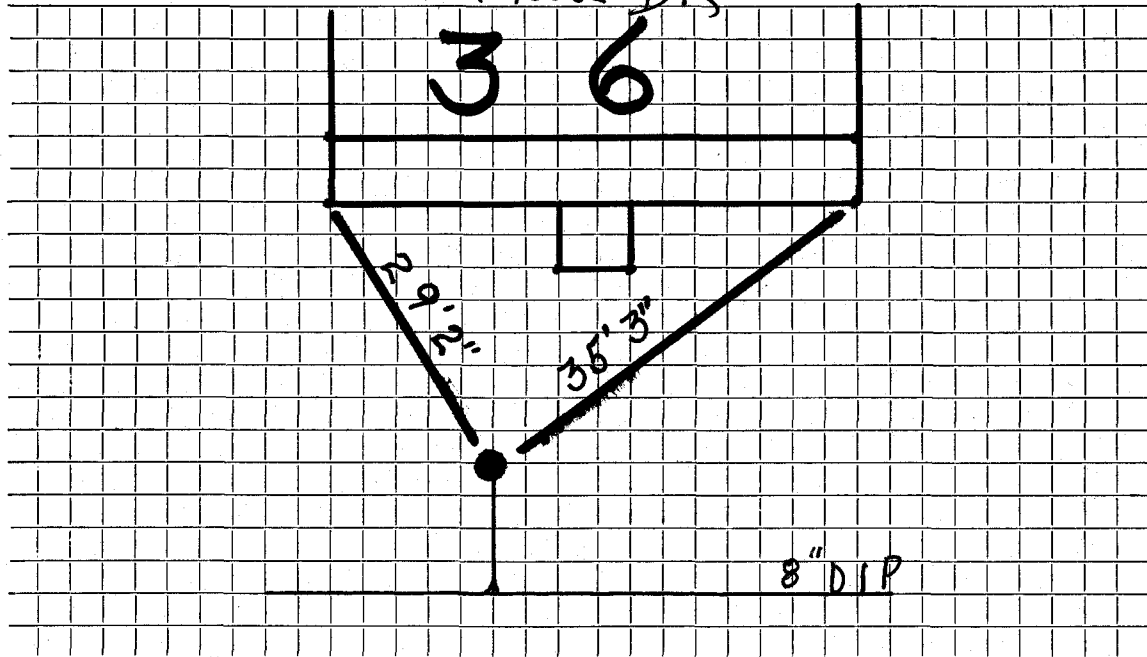

Connection made in Street. Work completed

Remarks: Original Service 1-3-28

.....
.....