


DATE _____

TOWN OF LEXINGTON — BOARD OF PUBLIC WORKS

WATER DIVISION

Sketch of Service Here

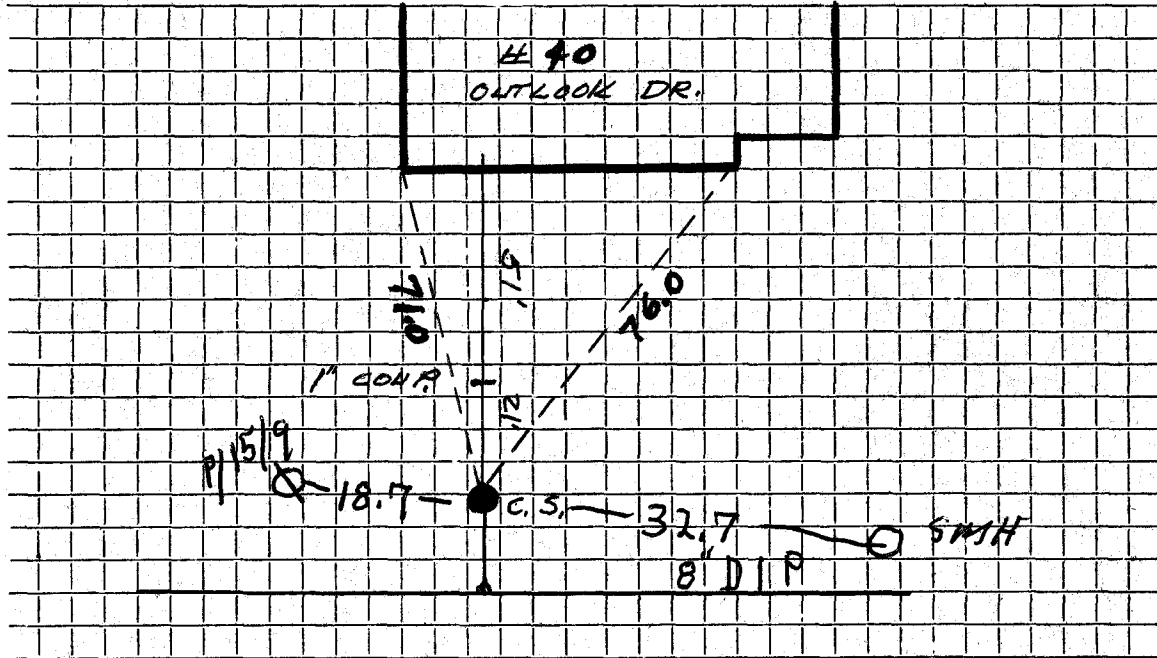

Connection made in OUTLOOK DRIVE Street. Work completed

Remarks: RE-NEWAL Original Service 9-14-28