

Name S. M. Nelson

Service No. ~~32 56~~ 2133

Address 128 Paul Revere Road, Arlington,

41 Outlook Drive

Location

#41 Outlook Drive.

#6087
#6725

Kind of Pipe

Size

Size of Main

~~Repair~~ New Service

Location

Date
1937

Material

Amount

Total

Date

Amount

6/5/37

2 hrs. @ 60¢

1 20

June 7, 1937

Deposited

32 50

65' 3/4" Copper Tubing @ 25¢

16 25

1 3/2" C. Union

90

OCT 2002

Dem
23' 1" Copper

1 3/4" S. & W,

3 75

1" CorP

2 hrs. trucking @ 75¢

1 50

1" Comb STOP

23 60

1" x 3/4 Red

Buff 10 box

Flat Rate:

65' @ 50¢

\$ 32 50

No Patching

Labor

6-1-37
2-2-37

DATE June 17, 1937

TOWN OF LEXINGTON—BOARD OF PUBLIC WORKS

WATER DIVISION

The undersigned applies for a supply of water at No. 41 Outlook Drive St. and hereby agrees to comply with the rules and regulations as now, or at any future time, established by the Board of Selectmen.

Am't. of Estimate \$ _____

Owner

S. M. Nelson

Am't. Paid \$ _____


Address

128 Paul Revere Rd.

Builder S. Nelson

Arlington Mass

Sketch of Service Here

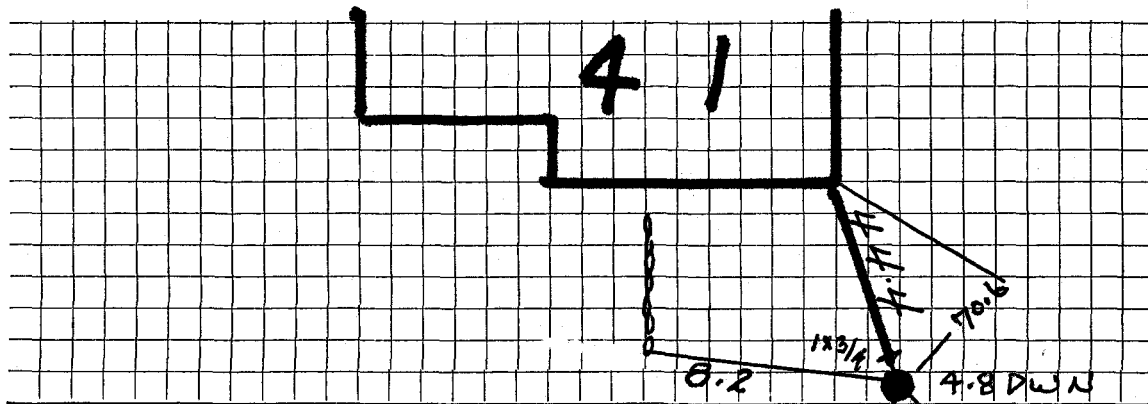

Connection made in _____ Street.

Remarks:

Work completed

2602 19

8" W-DIP
46.2"
4.5 DWN
4.8 DWN
CB