

WATER SERVICE RECORD

261

Name

Service No.

Address

45 Outlook Drive


Location

~~Repair~~—Renewal—New Service

Date	Material	Amount	Total	Date	Demt	Amount
3-28-	28			Oct 01 21'	1" Copper	
	38'	1" C.L. Pipe			1" Corp + 1" Curb Stop	
	3	1" L.L. Coupling			1X3/4 Red Buff box	
	1	1" L.L. Elbow			NON CHARGE	
	1	1" Br. Sp. Nipple		1/12/56	Lebor	24 27
	1	STOP + Waste		22	3/4" Copper tubing @.4396	9 67
				1	3/4" Corp Cock	4 61
				1	3/4" Carb Cock	5 91
				1	Box & Rod	4 62
				3	2/3 Hrs. Littlefield Show. @8.50	28 33
				2	Hrs. trucking @.75	1 50
						77 98

TOWN OF LEXINGTON — BOARD OF PUBLIC WORKS
WATER DIVISION

Sketch of Service Here

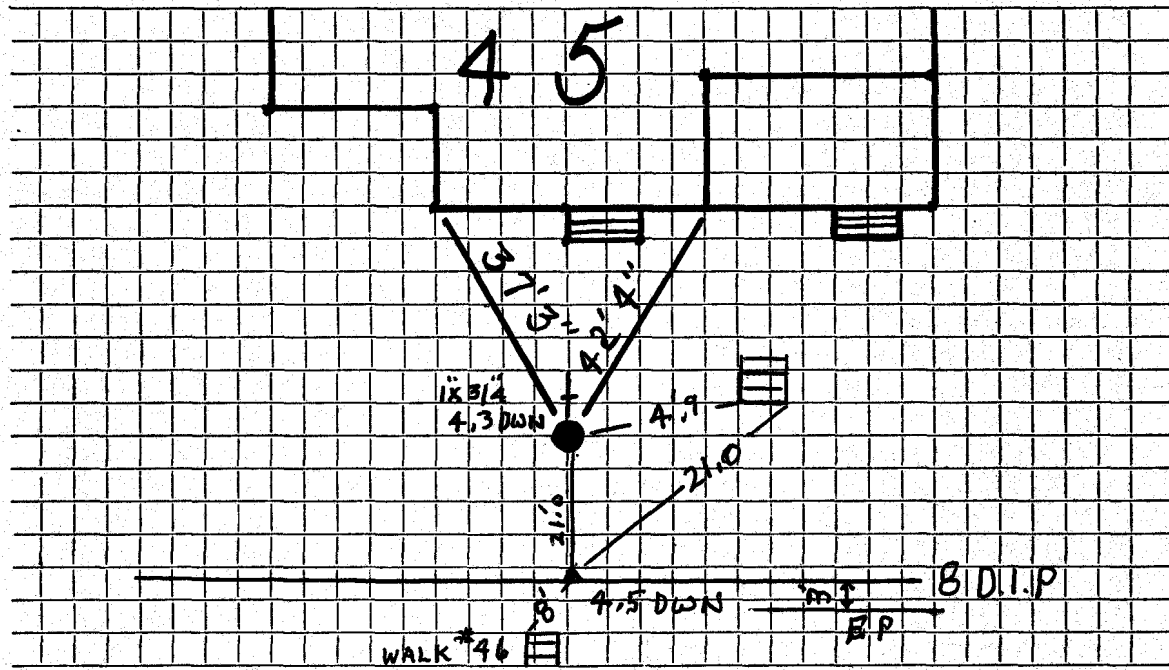

Connection made in Street. Work completed

Remarks: *Original... Service... 3-28-28*

.....
