




DATE \_\_\_\_\_

# TOWN OF LEXINGTON — BOARD OF PUBLIC WORKS

## WATER DIVISION

Sketch of Service Here  
OUTLOOK DR

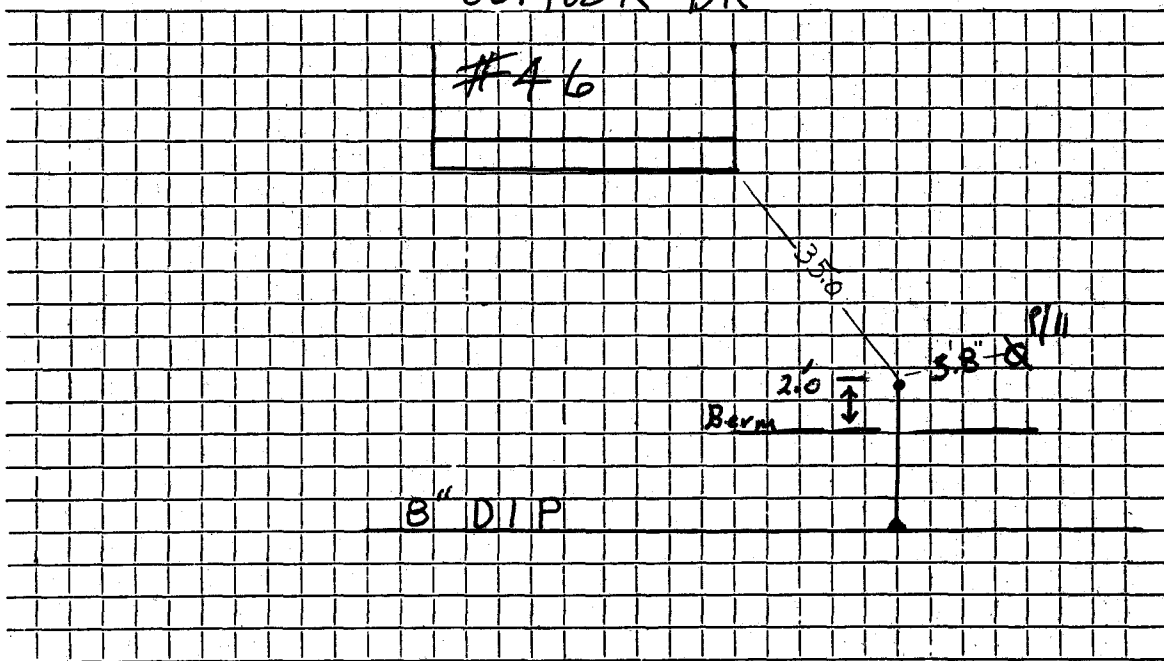

Connection made in ..... Street. Work completed oct 2002 .....

Remarks: No info in Times book & ties .....