


TOWN OF LEXINGTON — BOARD OF PUBLIC WORKS

WATER DIVISION

Sketch of Service Here
OUTLOOK DR.

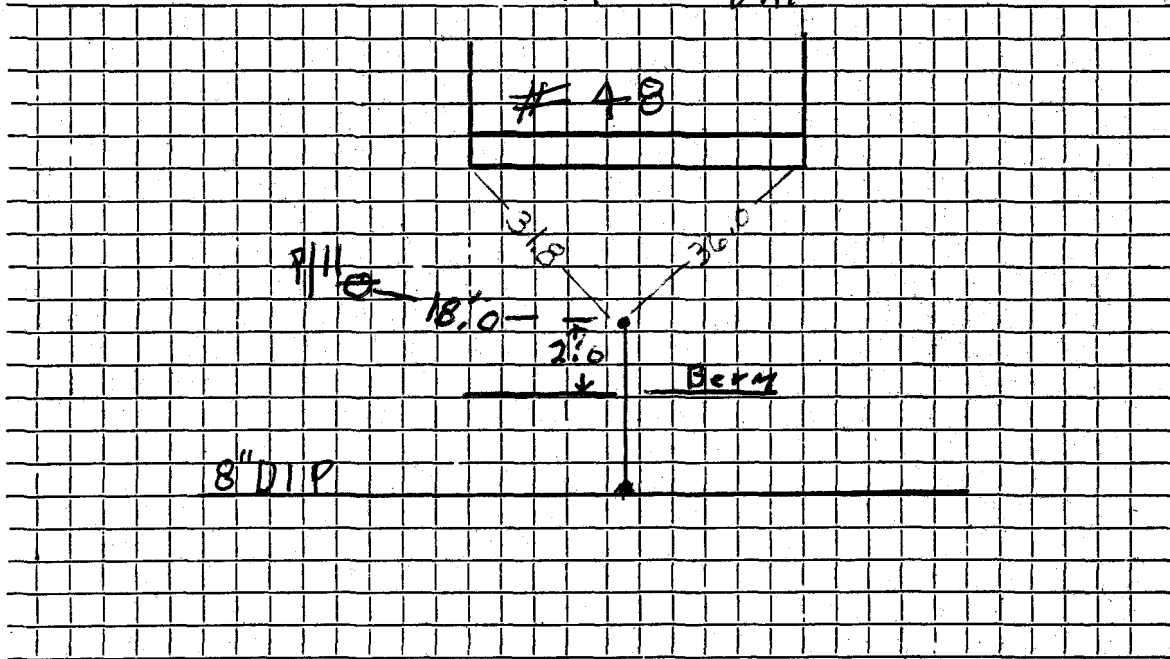

Connection made in Street. Work completed 2002

Remarks: No info. in Truss back to Truss

.....

.....