

Name Harold C. Nickerson • 378 Medford Street, Somerville

1937 - # ~~2138~~ 2138
Service No.

Address 54 Outlook Drive

2511

Location 54 Outlook Drive

Rate
acc't = 8945

Kind of Pipe

Size

Size of Main

~~Repairs General~~ — New Service

Location

Date 1937	Material	Amount	Total	Date	Amount
Apr. 1, '37	2 hrs. @ 60¢	1 20	1 20	<i>Feb 6, 1937 Deposited</i>	18 50
<i>COM 4-20-37</i>	31' 1" Cop. Tub. @ 25¢		7 75		
	1 1"x 3/4" S. & W.		3 00		
	4 hrs. trucking @ 75¢		3 00		
			<u>14 95</u>		
Say:	31' @ 50¢	15 50			
	Trucking	<u>3 00</u>	18 50		
	Labor				

Hadley Press, Inc., Lexington

DATE Feb. 4, 1937

TOWN OF LEXINGTON—BOARD OF PUBLIC WORKS

WATER DIVISION

The undersigned applies for a supply of water at No. 54 Outlook Drive St. and hereby agrees to comply with the rules and regulations as now, or at any future time, established by the Board of Selectmen.

Am't. of Estimate \$ 37' @ .50 18.50

Owner Harold G. Mickerson

Am't. Paid \$ _____


Address 378 Medford St.

Ms. Halpern
Builder Model Homes Inc.

Somerville Mass.

Gen. 137 new house at 13 East
41507

Sketch of Service Here

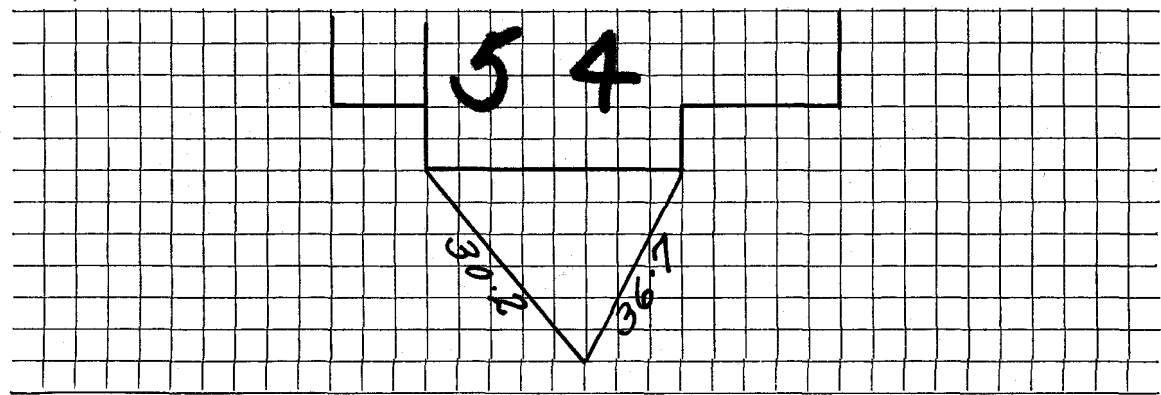

Connection made in _____ Street.

Work completed _____ 19

Remarks: