

WATER SERVICE RECORD

Name Mrs. Rick

Service No.

Address 58 Outlook Drive

Location

~~Repair~~—Renewal—~~New Service~~ Kirkland & Shaw #4072


| Date    |     | Material           | Amount | Total | Date         | Amount                              |
|---------|-----|--------------------|--------|-------|--------------|-------------------------------------|
| 7/23/82 | 45' | 3/4" Copper tubing |        |       |              |                                     |
|         | 1   | 3/4" Stop & Waste  |        |       |              |                                     |
|         |     |                    |        |       | 7/9/82       | Labor                               |
|         |     |                    |        |       | 25.6'        | Copper tubing                       |
|         |     |                    |        |       | 1            | Corporation                         |
|         |     |                    |        |       | <del>1</del> | <del>3/4" x 6" Nipple</del>         |
|         |     |                    |        |       | <del>1</del> | <del>Style 38 Dresser Clamp</del>   |
|         |     |                    |        |       | <del>1</del> | <del>3/4" Lead Lined Coupling</del> |
|         |     |                    |        |       | 1            | 3/4" Curb                           |
|         |     |                    |        |       | 1            | Box & Rod                           |
|         |     |                    |        |       | 8            | hrs. Pick-up                        |
|         |     |                    |        |       | 8            | hrs. Trucking                       |
|         |     |                    |        |       | 8            | hrs. Case                           |

DATE \_\_\_\_\_

TOWN OF LEXINGTON — BOARD OF PUBLIC WORKS

WATER DIVISION

Sketch of Service Here

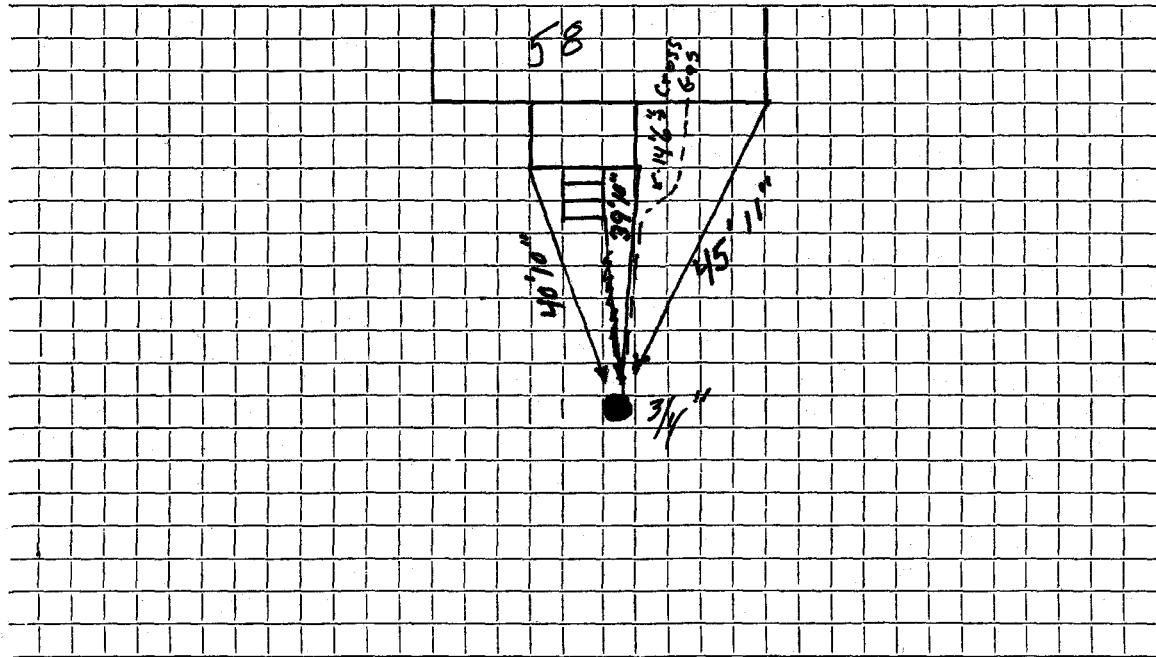

Connection made in ..... Street. Work completed .....

Remarks: *From house out 29' Pipe is Insulated* .....

.....  
.....