

WATER SERVICE RECORD

Name John Nygard

Service No. 312

Address 59 Outlook Drive

Location

~~Repair - Renewal~~ - New Service


Com. 12-31-54

Date	Material	Amount	Total	Date	Amount
12/29/54	Labor	1 85		12-22-54	Deposited 50 00
	10% overhead	19	2 04	12-31-54	Refunded (9 29
	92'- 3/4" copper tubing @ .35		32 20		NON CHARGE 40 71
	1-3/4" Cx 1/2" I.W.H. stop & waste		4 00	12/29/54	Labor 1 85
	1-3/4" Cx 3/4" C. Union		1 72	12'- 3/4" copper tubing @ .35	4 20
	1 hr. trucking		75	1 - 3/4" C. corp-cock	4 33
			40 71	1 - 3/4" C.x 3/4" C. curb-cock	4 67
				1 box & rod	3 90
				1 - 1/2" straight tail piece	50
				1 - 1/2" offset tail piece	50
				1 hr. trucking	75
					20 70

TOWN OF LEXINGTON — BOARD OF PUBLIC WORKS

WATER DIVISION

Sketch of Service Here

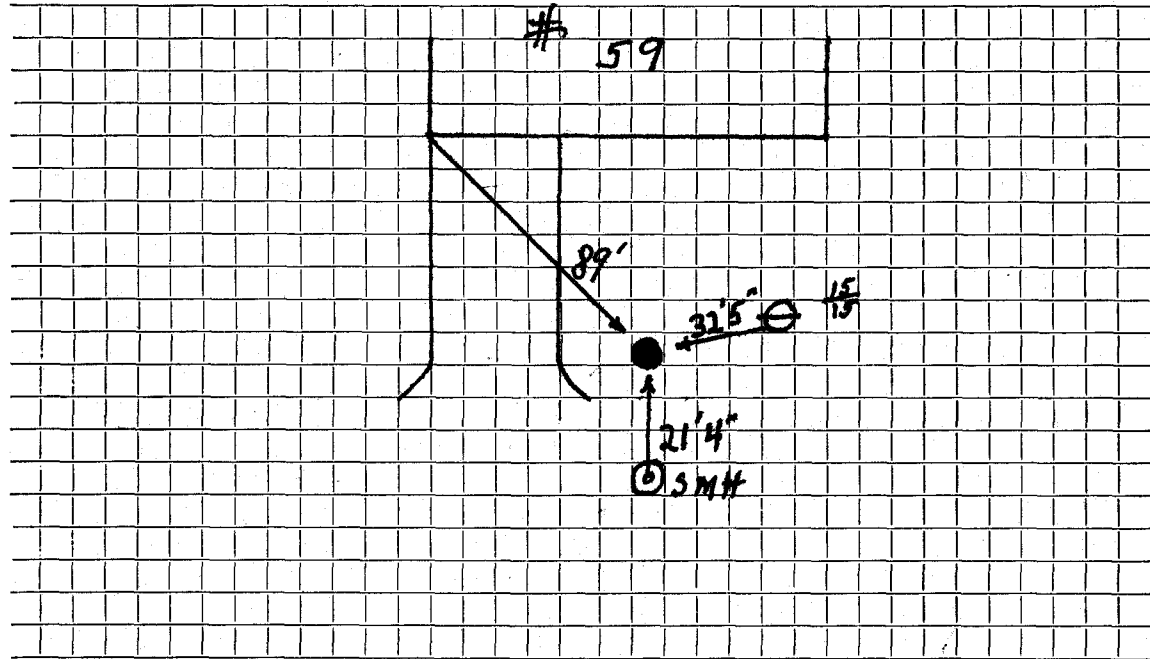

Connection made in Street. Work completed

Remarks:

.....
.....