

Name Walter Johnson

Service No. ~~2141~~ 2141

Address 65 Sprague St., Malden
65 Outlook Drive

#5635
#7222

Location 65 Outlook Drive, Lexington

Kind of Pipe

Size

Size of Main

~~Repair - Renewal - New Service~~

Location

| Date | Material | Amount | Total | Date | Amount |
|--|--------------------------|--------|-------|--|----------------------|
| 1936 April 8 | 9 hrs. labor @ 50¢ | 4 50 | | 4-3-36 | Deposited Balance |
| <i>Com. 261.20 to Russell 6-9-36</i> | 9 " " @ 55¢ | 4 95 | 9 45 | 8-13-36 | |
| | 10% Ovhd. on labor | | 95 | | 49 50 |
| | 136 3/4" Cop. Tub. @ 15¢ | 20 40 | | | 11 70 |
| | 2 3/4" Cop. Unions @ 75¢ | 1 50 | | | 61 20 |
| | 1 S. & W. | 1 75 | | | |
| | 2 hrs. Turck. @ 75¢ | 1 50 | 25 15 | | |
| | | | 35 55 | | |
| | Chge. 136 ! @ 45¢ = | | 61 20 | | |
| | Labor | | | <i>Bell mail sent 6-9-36 to Franklin A.T. 8-6-36</i> | |

Hadley Press, Inc., Lexington

110' @ 45¢ = 449.50

DATE _____

TOWN OF LEXINGTON—BOARD OF PUBLIC WORKS WATER DIVISION

The undersigned applies for a supply of water at No. 65 Outlook Drive St. and hereby agrees to comply with the rules and regulations as now, or at any future time, established by the Board of Selectmen.

Am't. of Estimate \$ _____

Owner.

Walter Johnson (by J. Adams)


Am't. Paid \$ _____

Address

66 Sprague St., Malden.

Builder M. B. Jenkins

Sketch of Service Here

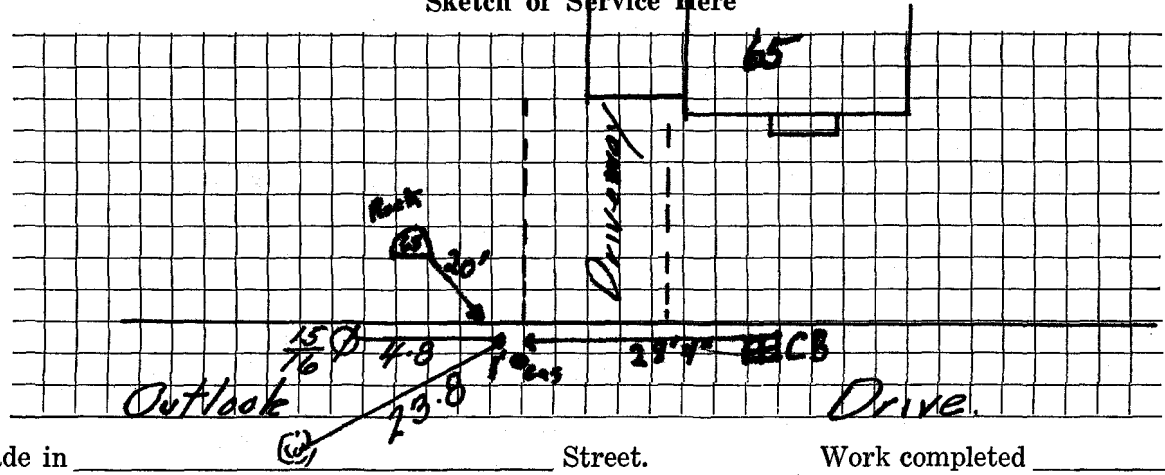

Connection made in _____ Street.

Work completed _____ 19

Remarks: