
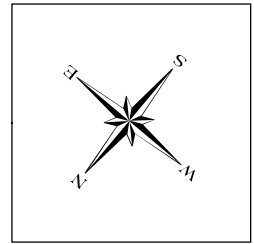


**Water Service Tie Card**  
**TOWN OF LEXINGTON**  
 MASSACHUSETTS

**67 Outlook Drive**

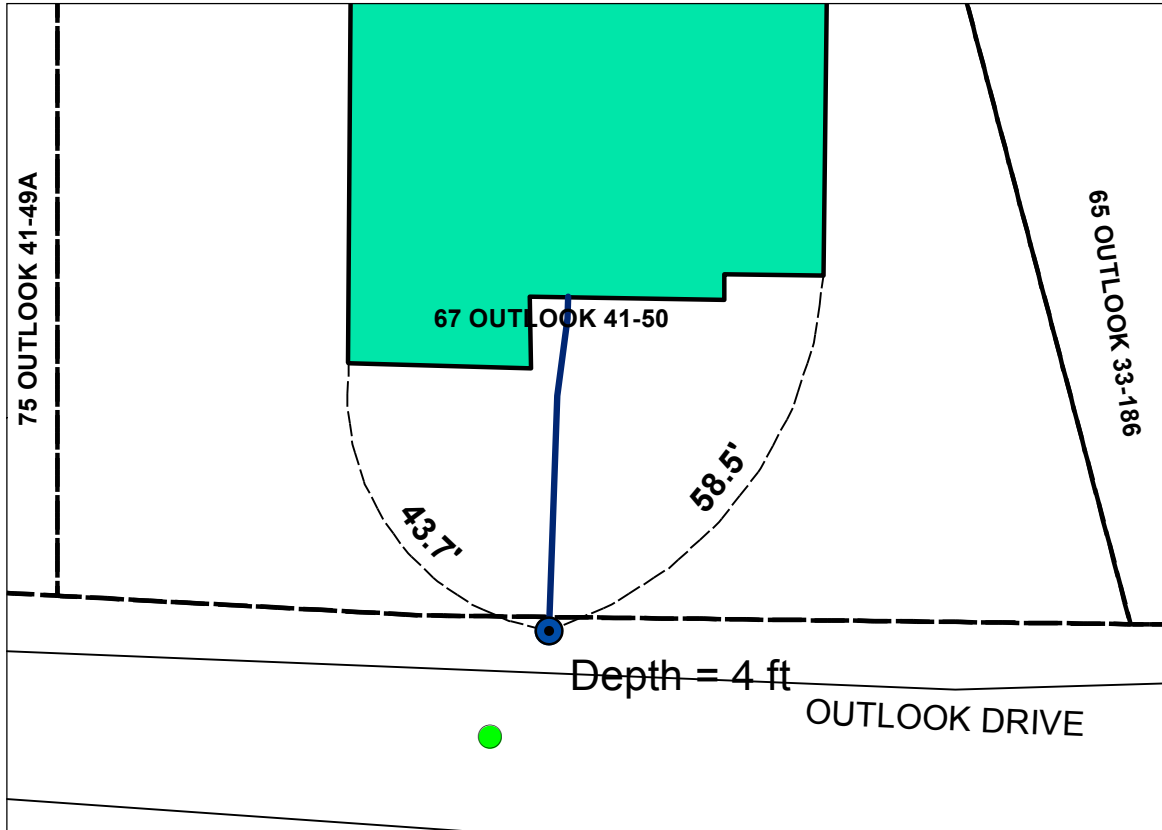

Legend	
<span style="color: blue;">●</span>	Curb Stop
---	Ties_Dimensions
<span style="color: blue;">—</span>	Water Service Line
---	Property Line
---	Edge of Pavement
<span style="background-color: cyan; border: 1px solid black; display: inline-block; width: 15px; height: 10px;"></span>	CATCH BASIN
<span style="color: green;">●</span>	SMH

Address	Map and Lot	Permit Number	Contractor Name	Inspector
67 Outlook Drive	41-50	5530	McLaughlin, James M. Inc.	D. Pavlik

Date: 3/6/14	Material	Amount
	1" Copper type "k"	1 Foot
	1" Curb Valve and Buffalo Box	1
	1" Copper type "k"	44 Feet

**Type of work completed**  
 New 1" water service to house from curb stop. New house on lot old house removed.