

Name Walter Bernard

Service No. ~~50 2143~~

#3763

2143

Address 68 Outlook Drive

#68

Location

Lot 147 Outlook Drive

Kind of Pipe

Size

Size of Main

~~Repair-Renewal~~ New Service

Location

Date

Material

Amount

Total

Date

Amount

37 1" C.L. Pipe @ .27

9 99

1 1" L.L. Ell

35

1 1" Br. Sp. Nipple

25

2 1" L.L. Coup. @ .25

50

Trucking

75

11 84

7 Hrs. Labor @ .55

3 85

2 " " @ .60

1 20

5 05

15% Overhead

76

17 65

May 29 1928 - Cash  
June 20 1929 - Cash

15 00

2 65

Labor

Copper cutters

10/22/82 JPM

Headley Press, Inc., Washington

Tr. ch. dug.

DATE May 29, 1928.

# TOWN OF LEXINGTON—BOARD OF PUBLIC WORKS

## WATER DIVISION

Lot.

The undersigned applies for a supply of water at No. 147 - Outlook Drive St. and hereby agrees to comply with the rules and regulations as now, or at any future time, established by the Board of Selectmen.

Am't. of Estimate \$ \_\_\_\_\_

Owner Walter Bernard.


Am't. Paid \$ 15<sup>00</sup>

Address 16 Outlook Drive

Builder \_\_\_\_\_

Wm. MacArthur  
By

Sketch of Service Here

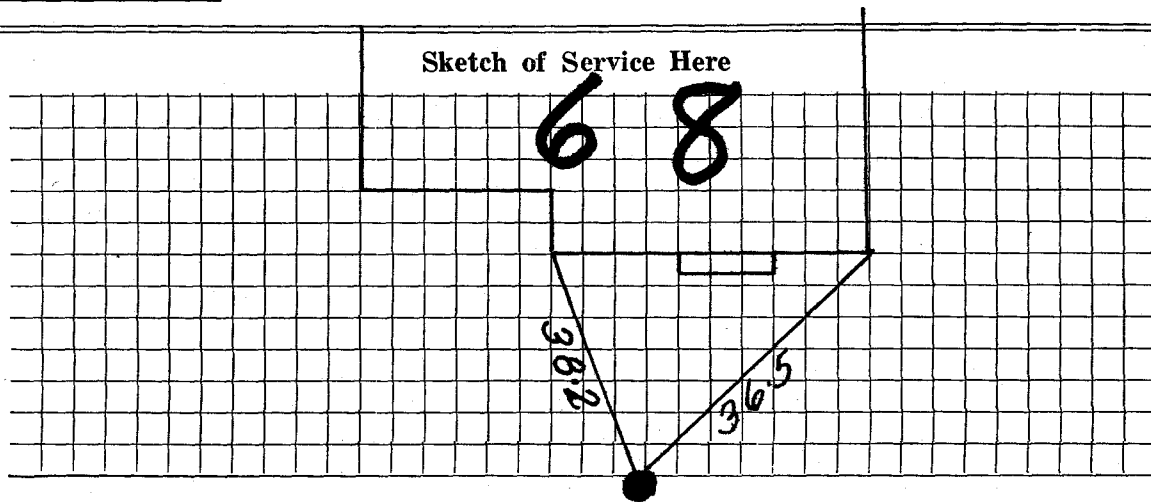

Connection made in \_\_\_\_\_ Street.

Work completed \_\_\_\_\_ 19

Remarks: