

Geza Hauck

Service No. 162144 ✓

Address 70 Outlook Drive

# 6585

Lexington, Mass.

Location 70 Outlook Drive

Kind of Pipe

Size

Size of Main

~~Repair~~—Renewal—~~New Service~~

Location

Date

Material

Amount

Total

Date

Amount

No labor charge

work done after hours

38' - 3/4" Copper Tubing

7 27

1 - 3/4" c x 1/2" I.W.H. Stop & Waste

2 58

9 85

*No Deposit  
paid*

9 85

Non-Charge

9' - 3/4" Copper Tubing

1 71

1 - 3/4" c x 3/4" C. Curb-cock

3 02

1 - 3/4" C. Adapter

1 19

Trucking 1 hr.

75

6 67

Labor

Hadley Press, Inc., Lexington

8-22-28

37' 1" C. L. Pipe

2 1" L. L. Couplings

2 1" L. L. ELLs.

1 Br. Sp. Nipple

1 Stop + Waste

DATE \_\_\_\_\_

# TOWN OF LEXINGTON—BOARD OF PUBLIC WORKS

## WATER DIVISION

The undersigned applies for a supply of water at No. \_\_\_\_\_ St. and hereby agrees to comply with the rules and regulations as now, or at any future time, established by the Board of Selectmen.

Am't. of Estimate \$ \_\_\_\_\_


Owner \_\_\_\_\_

Am't. Paid \$ \_\_\_\_\_

Address \_\_\_\_\_

Builder \_\_\_\_\_

Sketch of Service Here

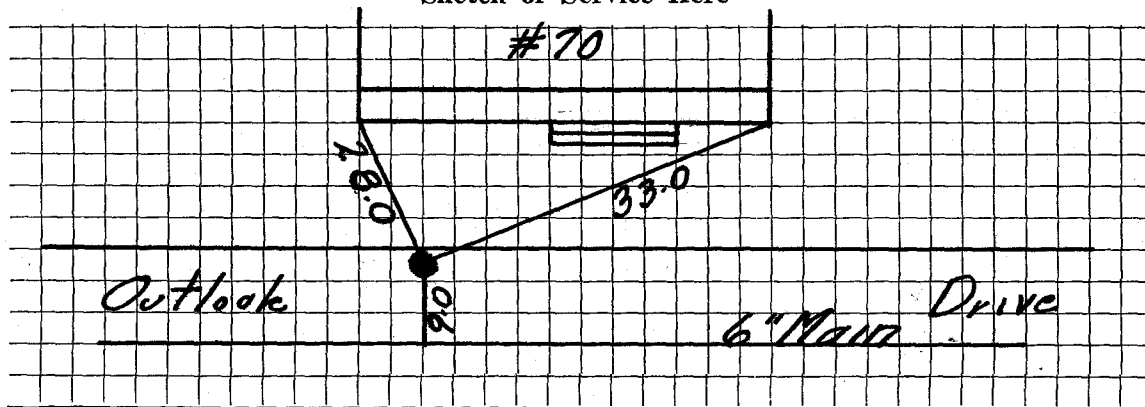

Connection made in \_\_\_\_\_ Street.

Work completed \_\_\_\_\_ 19

Remarks: