

Mrs. George E. Briggs

1256  
Service No. 2145

75 Outlook Drive. Lexington

Location

Kind of Pipe

Size

Size of Main

~~Repair~~ - Renewal - ~~NEW SERVICE~~

Location

Date	Material	Amount	Total	Date	Amount
1943					
May 26.	12 hrs. @ 55¢	6 60		May 18, 1943 Deposited	150 00
Com 7/12/43	64 " @ 65¢	41 60		July 12, 1943 Renewed	1 56
	25 " @ 70¢	17 50			
	25 " @ 80¢	20 00	85 70		
	10% Overhead		8 57		
	128' 1 1/2" C.L. Pipe @ 33¢		42 24	Non-chargeable:	
	1 1 1/2" I x 1 1/2" I.W.H.S. & W.		2 82	Labor	25 10
	1 2" x 1 1/2" L.L. Coupling		60	11' 2" C.L. Pipe @ 45¢	4 95
	5 1 1/2" L.L. Couplings @ 44¢	2 20		12' 1" Copper tubing @ 22¢	2 64
	1 1 1/2" L.L. Union	1 30		1 1" Cx2" I 2-way branch	4 17
	1 1 1/2" x 1" Brass Red. Coupling	80		1" C. adapters	3 40
	1 1 1/2" Brass close Nipple	46		1 2" T.H. Gate valve	11 55
	1 hr. compressor	2 25		1 2" L.L. Couplings	48
	2 " trucking @ 75¢	1 50		1 2" Brass close nipple	15
			148 44	1 box & rod	1 65
				1 hr. trucking	75
					54 84
	Labor				

Hadley Press, Inc., Lexington

DATE \_\_\_\_\_

# TOWN OF LEXINGTON—BOARD OF PUBLIC WORKS

## WATER DIVISION

The undersigned applies for a supply of water at No. 75 Outlook Dr. St. and hereby agrees to comply with the rules and regulations as now, or at any future time, established by the Board of Selectmen.

Am't. of Estimate \$ \_\_\_\_\_

Owner


Mr. George E. Briggs

Am't. Paid \$ \_\_\_\_\_

Address

Builder \_\_\_\_\_

Sketch of Service Here

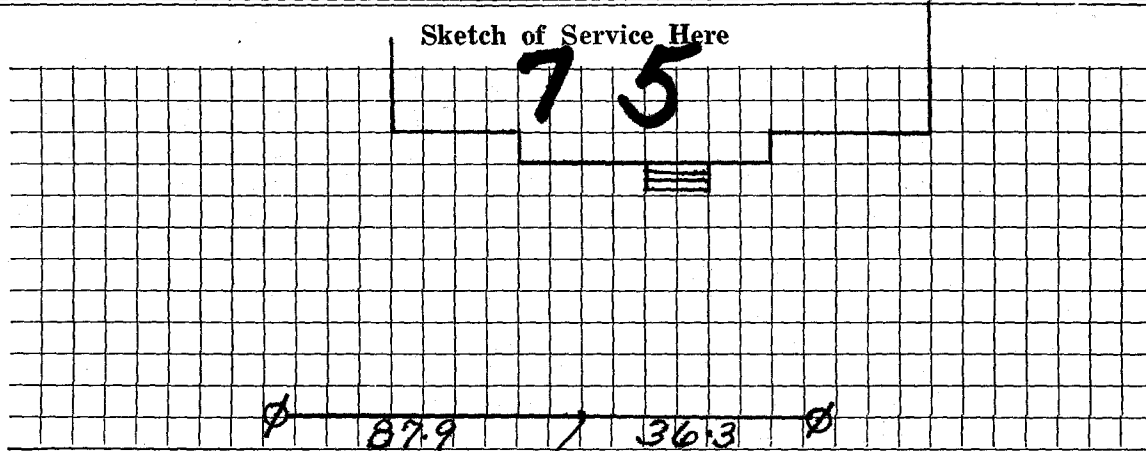

Connection made in \_\_\_\_\_

Street.

Work completed \_\_\_\_\_

19

Remarks: