

Name Oscar W. Carlson

Service No. 47

Address 80 Outlook Drive

986

Lexington, Mass.

Location 80 Outlook Drive

Kind of Pipe

Size

Size of Main

~~Repair-Renewal~~ - New Service

Com. 5/22/50

Location

Date	Material	Amount	Total	Date	Amount
Apr. 11, '50	Labor	4 90	4 90	April 15 '50	45 00
	10% Overhead		49	May 21 '50	6 25
	34' - 3/4" Copper Tubing @.23		7 82		38 25
	1 - 3/4" C x 1/2" I.W.H. S&W		3 29		No Charge
	Littlefield Shovel 3 hrs. @ 7.00		21 00	Apr. 11, '50	12 25
	Trucking 1 hr. @ .75		75	60' - 3/4" Copper Tubing @.23	13 80
			38 25	1 - 3/4" C Corp-cock	3 15
				1 - 3/4" C x 3/4" C Curb-cock	3 85
				1 - Box & Rod	3 70
				1 - 1/2" Straight Tail Piece	38
				1 - 1/2" Offset Tail Piece	38
				Littlefield Shovel 1 hr. @ 7.00	7 00
				Trucking 1 hr. @ .75	75
	Labor				73 26

TOWN OF LEXINGTON – BOARD OF PUBLIC WORKS

WATER DIVISION

The undersigned applies for a supply of water at No..... St. and hereby agrees to comply with the rules and regulations as now, or at any future time, established by the Board of Selectmen.

Am't of Estimate \$.....

Owner


Am't Paid \$.....

Address

Builder

.....

Sketch of Service Here

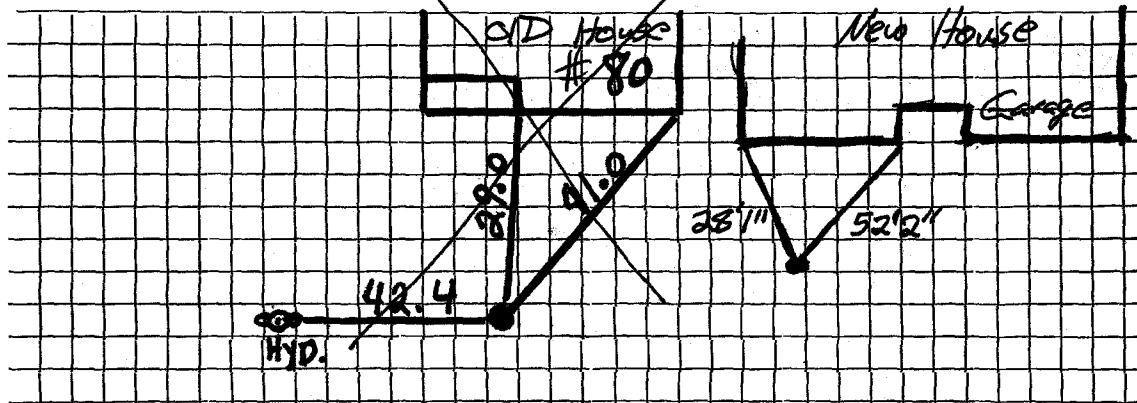

Connection made in Street.

Work completed19

Remarks: