

WATER SERVICE RECORD

Name Robert Ericson

Service No. 165

Address 88 Outlook Drive

7552

Location

~~Repairs-Renewal-New Service~~

Comm 11-9-59


Date	Material	Amount	Total	Date	Amount	
8-7-59	Labor	24 23		7-27-59	Deposit	75 00
	10% O. H.	2 42	26 65	11-9-59	Returned	
57'	3/4" Copper tubing @.41		23 37			66 36
1	3/4" C x 1/2 I.W. H.Stop & Waste	5 84			<u>NON CHARGE</u>	
1 1/2	Hrs. Town Shovel @6.50	9 75	8-7-59	Labor	6 37	
1	Hr. Trucking @.75	75		15'	3/4" Copper tubing @.41	6 15
			66 36	1	3/4" C Corp Cock	4 64
				1	3/4" C Curb Cock	5 94
				1	Box & Rod	5 00
				1	1/2 Striaht Tailpiece	50
				1	1/2 Offwet Tailpiece	50
				1/2	Hr. Town Shovel @6.50	3 25
						32 35

DATE _____

TOWN OF LEXINGTON — BOARD OF PUBLIC WORKS

WATER DIVISION

Sketch of Service Here

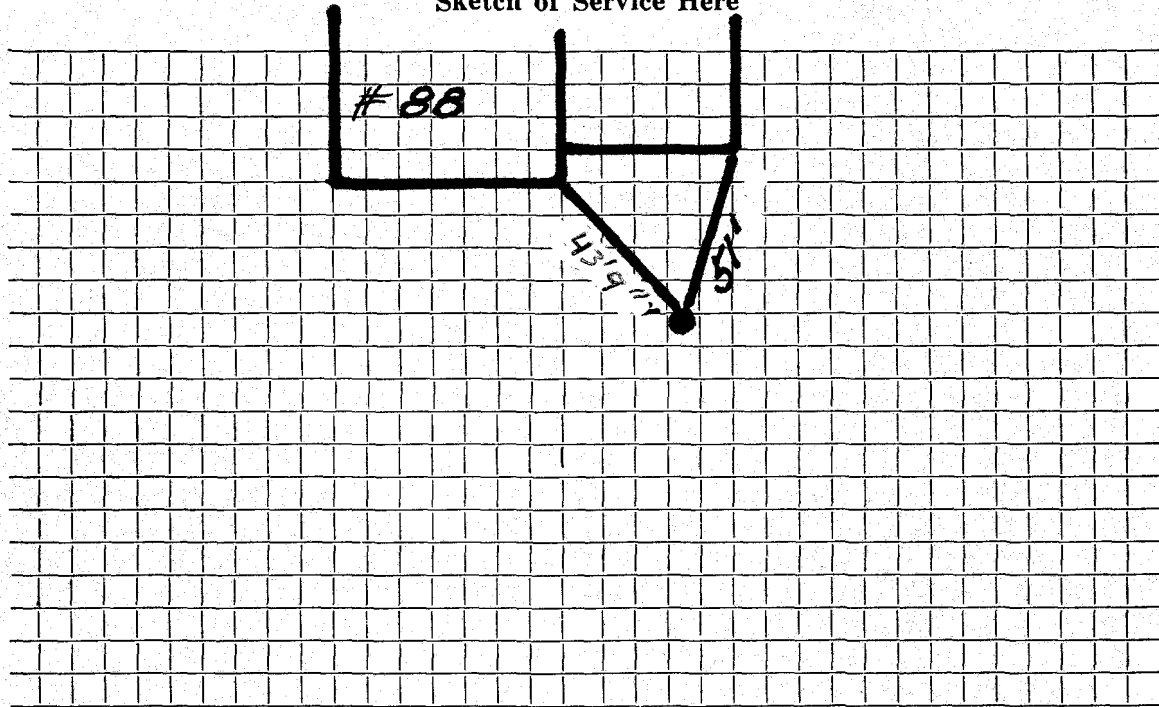

Connection made in Street. Work completed

Remarks:
.....
.....