

WATER SERVICE RECORD

Name Oscar Carlson

Service No. 122

Address 93 Outlook Drive

#7745

Location

~~Repair - Renewal~~ - New Service

COM. 7-19-54


Date	Material	Amount	Total	Date	Amount
6/15/54	Labor	5 17		6-1-54 Deposited	50 00
	10% overhead	52	5 69	7-20-54 Refunded	9 86
	42' - 3/4" copper tubing@.35		14 70	<u>NON CHARGE</u>	40 14
	1 - 3/4" c x 1/2 I.W.H.stop& waste	4 00	4 00	6/15/54 Labor	5 18
	2 hrs.Littlefield shovel	7.50	15 00	8' - 3/4" copper tubing@.35	2 80
	1 hr. trucking		75	1 - 3/4"C. corp-cock	4 33
			40 14	1 - 3/4"C. curb-cock	4 67
				1 box and rod	3 90
				1 - 1/2 straight tail pc.	50
				1 - 1/2 offset tail pc.	50
				1 hr. Littlefield shovel	7 50
				1 hr. trucking	75
					<u>30 13</u>

DATE _____

TOWN OF LEXINGTON — BOARD OF PUBLIC WORKS

WATER DIVISION

Sketch of Service Here

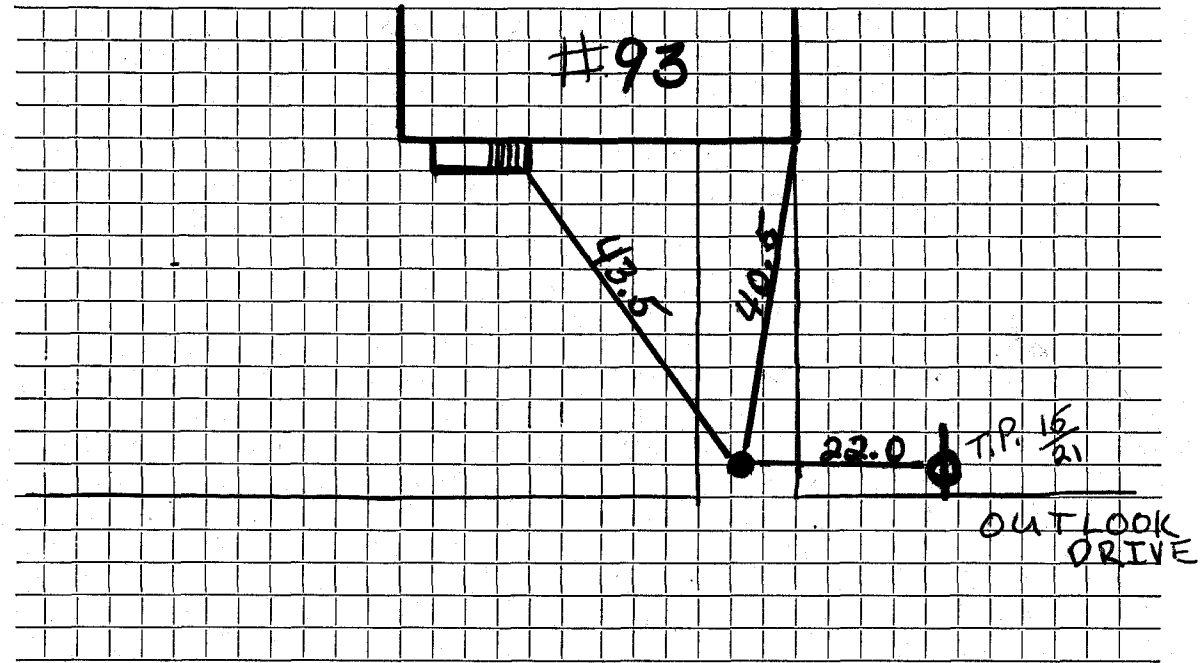

Connection made in Street. Work completed

Remarks:
.....
.....