

WATER SERVICE RECORD

Name Oscar Carlson

Service No. 49

Address 97 Outlook Drive

7642

Location

~~Repair~~ ~~Renewal~~ New Service

Am. 5-3-54


Date	Material	Amount	Total	Date	Amount
3/29/54	Labor	6 65		3-22-54	Deposited 50 00
	10% overhead	67	7 32	5-23-54	Refunded 18 18
	35 3/4" Copper tubing @.35		12 25		NON CHARGE 31 82
	1-3/4" Cx 1/2" I.W.H. Stop & waste	4 00	4 00	3/29/54	Labor 6 65
	1 hr. Littlefield shovel		7 50		1 3/4" Copper tubing @.35 4 90
	1 hr trucking		75		1-3/4" C.Curb cock 4 33
			31 82		1-3/4" Cx 3/4" C.Curb cock 4 67
					1 box & rod 3 90
					1-1/2" Straight tail piece 50
					1-1/2" Offset tail piece 50
					1 hr. Littlefield shovel 7 50
					1 hr trucking 75
					33 70

DATE _____

TOWN OF LEXINGTON — BOARD OF PUBLIC WORKS

WATER DIVISION

Sketch of Service Here

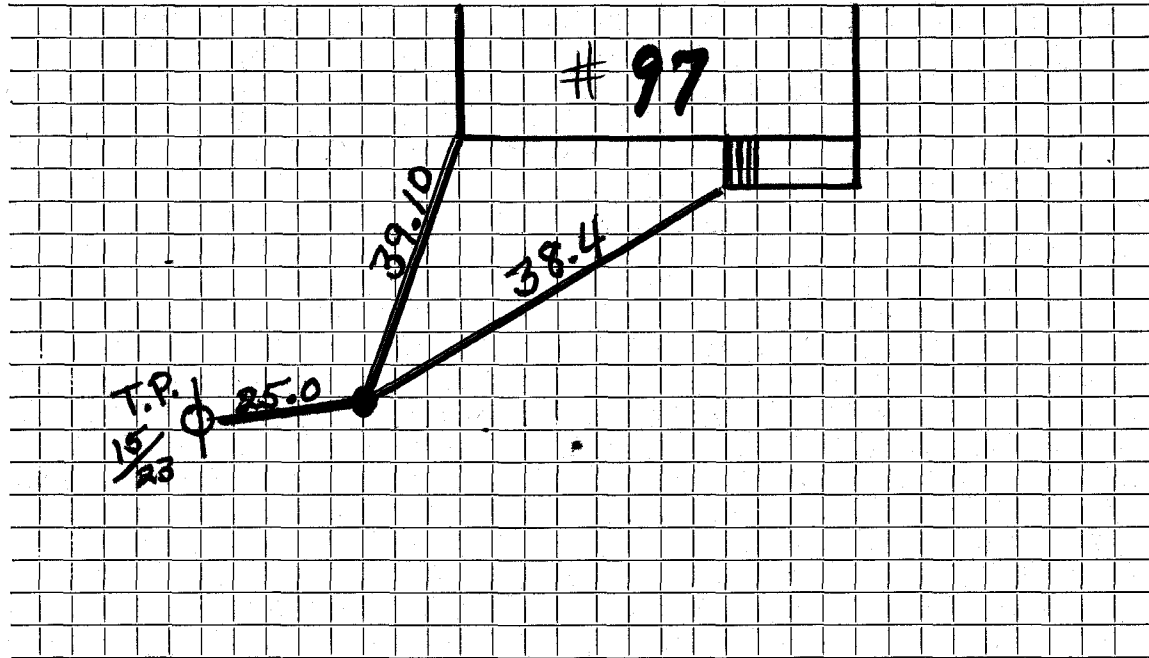

Connection made in Street. Work completed

Remarks:

.....

.....