

WATER SERVICE RECORD

Name Robert Eriuson

Service No. 107

Address 98 Outlook Drive

Location

~~Repair~~ ~~Renewal~~ New Service


Comm 8-22-60

Date	Material	Amount	Total	Date	Amount
7-11-60	Labor	19 65		6-29-60	Deposit 100 00
	10% O.H.	1 97	21 62	8-22-60	Returned 41 46
43'	3/4" Copper tubing @42		18 06		58 60
1	3/4" Cx 1/2 I.W.H. Stop&Waste		6 17		
1 1/2	Hr Town Shovel @6.50		9 75		NON CHARGE
1	Hr Trucking @3.00		3 00		Labor 12 80
			58 60	28'	3/4" Copper tubing @78- 21 84
				1	3/4" C Corp Cock 4 91
				1	3/4" C Curb Cock 6 28
				1	Box & Rod 4 90
				1	1/2 Straight tailpiece 50
				1	1/2 Offset tailpiece 50
					51 73

TOWN OF LEXINGTON — BOARD OF PUBLIC WORKS

WATER DIVISION

Sketch of Service Here

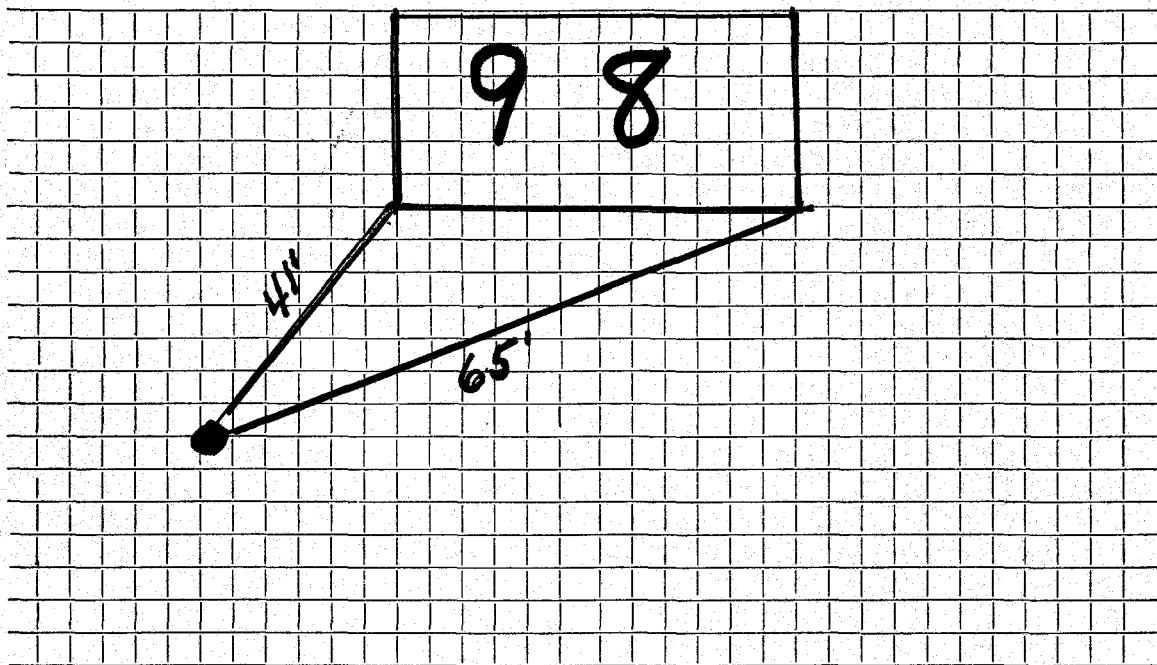

Connection made in Street. Work completed

Remarks:
.....
.....