

WATER SERVICE RECORD

3280

Name Leeland Construction Company

Service No. 118

Address 10 Oxbow Road Lexington 73, Massachusetts

#6929

Location

~~Repair Record~~ - New Service

Comm 8-3-58


Date	Material	Amount	Total	Date	Amount	
6-11-59	Labor	3.38		6-9-59	Deposit	100.00
	10% O.H.	.34	3.72	8-3-59	Returned	
	54' 3/4" Copper tubing @.3764		20.33			30.68
1	3/4" C x 1/2 I.W.H. Stop & Waste		5.98		NON CHARGE	
1	hr. Trucking @.75		.75	1958		
			30.68	32' 3/4" Copper Tubing @ 37		11.84
				1 3/4" C Corp Cock		4.64
				1 3/4" C Curb Cock		6.03
				1 Box & Rod		5.00
						27.51
				1 # Offset tailpiece		.50
				1 # Straight tailpiece		.50
						28.51

DATE \_\_\_\_\_

# TOWN OF LEXINGTON — BOARD OF PUBLIC WORKS

## WATER DIVISION

Sketch of Service Here

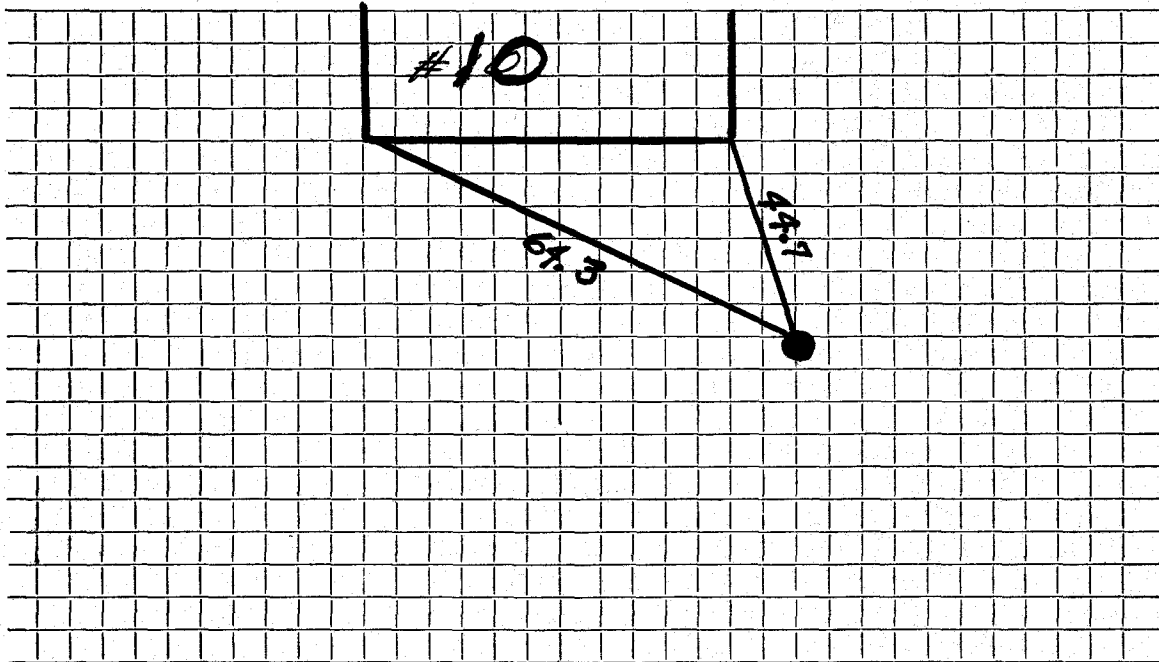

Connection made in ..... Street. Work completed .....

Remarks: .....  
.....  
.....