

## WATER SERVICE RECORD

Name Leeland Const. Co.

Service No. 224

Address 16 Oxbow Road

Location


~~Repair~~ ~~Renewal~~ New Service

Conn 12-31-59

Date	Material	Amount	Total	Date	Amount	
8-5-59	Labor	1 85		9/14/59	Deposit	50 00
	10% O. H.	19	2 04	12-31-59	Retained	1 14
	16' 3/4" Copper tubing @.38		6 08			42 84
	1 Hr. Trucking		75		NON CHARGE	
			8 87	8-5-59	Labor	1 85
11-5-59	Labor	3.70		24'	3/4" Copper tubing @.38	9 12
	10% O.H.	.37	4.07	1	3/4" C Corp Cock	4 67
	50' 3/4" Copper tubing @.42		21.00	1	3/4" C Curb Cock	6 07
	1 3/4" C x 1/2 W.W.H. Stop & Waste		5.88	1	Box & Rod	5 00
	1 3/4" C 3 part union		2.27			26 71
	1 hr. Trucking @.75		.75	1	1/2 Offset tailpiece	.50
			42.84	1	1/2 Straight tailpiece	.50
						27.71

TOWN OF LEXINGTON — BOARD OF PUBLIC WORKS  
**WATER DIVISION**

Sketch of Service Here

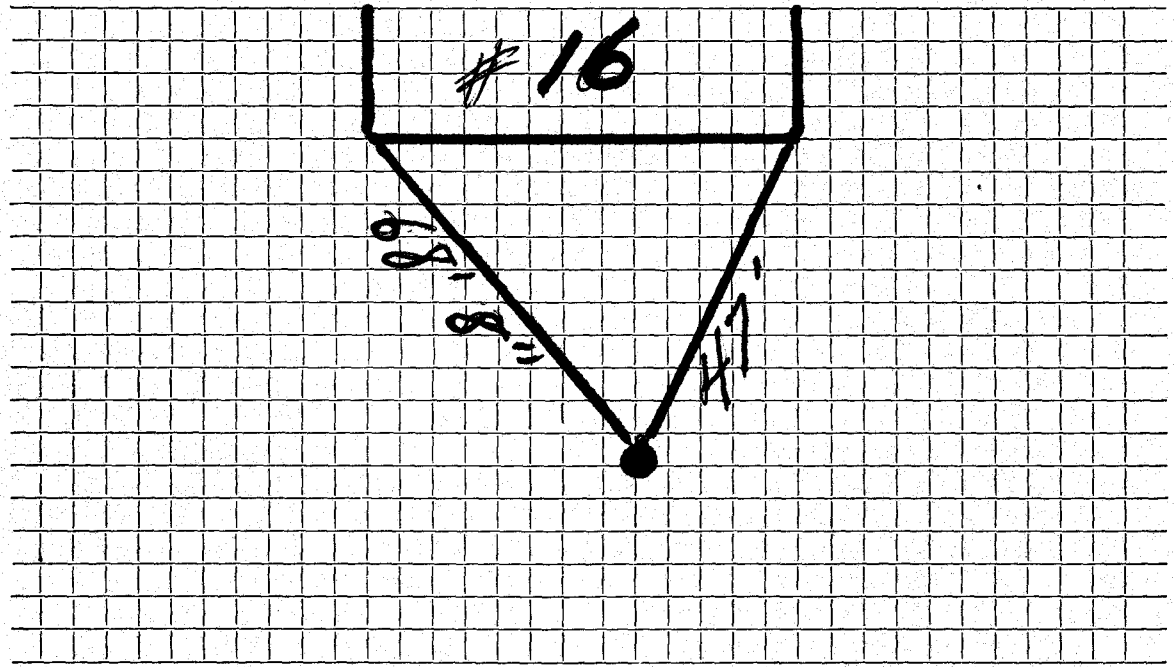

Connection made in ..... Street.                      Work completed .....

Remarks: .....  
.....  
.....