

WATER SERVICE RECORD

Name **Leeland Construction Company**

Service No. **150**

Address **17 Oxbow Road**

Location


~~Repair - Renewal~~ **New Service**

Annex 10-14-58

Date	Material	Amount	Total	Date		Amount
8-7-58	50' 3/4" Copper tubing @ .37		18.50		<i>Deposit</i>	25.00
	1 3/4" C x 1/2 I.W.H. Stop & Waste		5.84	11-14-58	<i>Apply Refund W.M.#.36</i>	1.61
	1 3/4" C Union 3 part		2.27			26.61
			26.61		NON CHARGE	
				8-7-58	10' 3/4" Copper tubing @.37	3.70
					1 3/4" C Corp Cock	4.64
					1 3/4" C Curb Cock	6.03
					1 Box & Rod	5.00
					1 1/2 Offset Tailpiece	.50
					1 1/2 Straight tailpiece	.50
						19.87

TOWN OF LEXINGTON — BOARD OF PUBLIC WORKS
WATER DIVISION

Sketch of Service Here

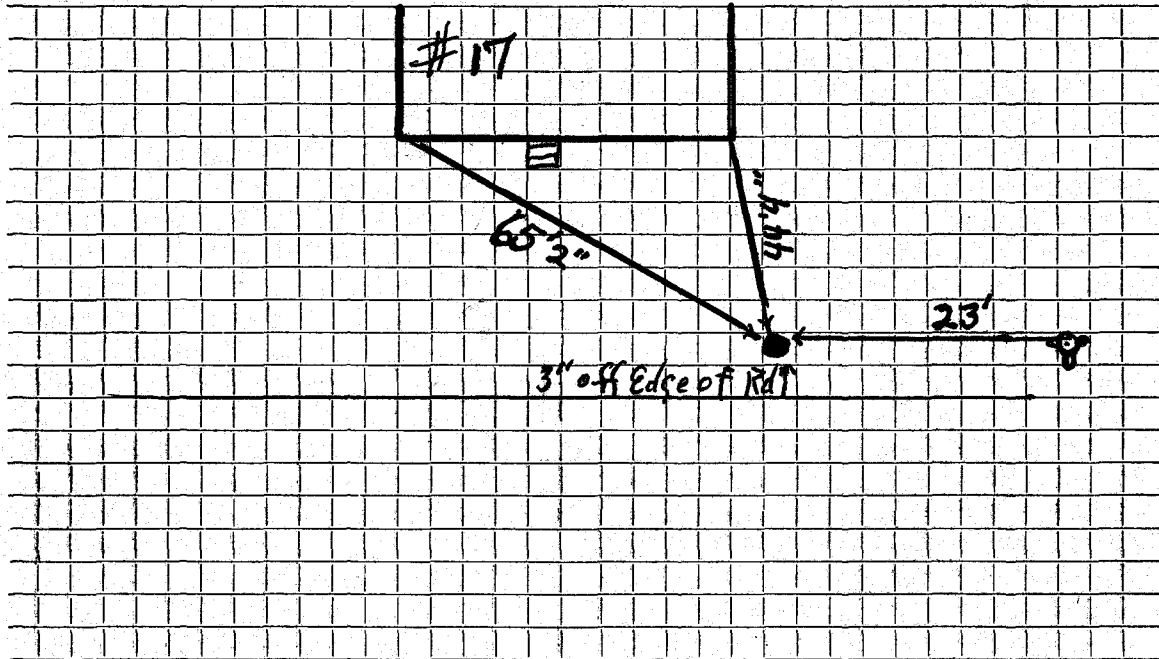

Connection made in Street. Work completed

Remarks:

.....

.....