

WATER SERVICE RECORD

Name Leeland Const. Co.

Service No. 254

Address 18 Oxbow Road

6921

Location

~~Repair~~ ~~Renewal~~ - New Service


Conn 12-31-59

Date	Material	Amount	Total	Date	Amount	
8-5-59	Labor	1 85		7-14-59	Deposit	50 00
	10% O. H.	19	2 04	12-31-59	Refund	12 02
	16' 3/4" Copper tubing @.38		6 08			37 98
	1 Hr. Trucking		75		<u>NON CHARGE</u>	
			8 87	8-5-59	Labor	1 85
	BILL WHEN CONNECTED				25' 3/4" Copper tubing @.38	9 50
11-6-59	Labor	1.95		1	3/4" C Corp Cock	4 67
	10% O.H.	.20	2.15	1	3/4" C Curb Cock	6 07
	43' 3/4" Copper tubing @.42		18.06	1	Box & Rod	5 00
	1 3/4" C x 1/2 I.W.H. Stio & Waste		5.88			27 09
	1 3/4" C 3 part union		2.27	1	1/2 Straight tailpiece	.50
	1 hr. Trucking @.75		.75	1	1/2 Offset tailpiece	.50
			37.98			28.09

TOWN OF LEXINGTON — BOARD OF PUBLIC WORKS

WATER DIVISION

Sketch of Service Here

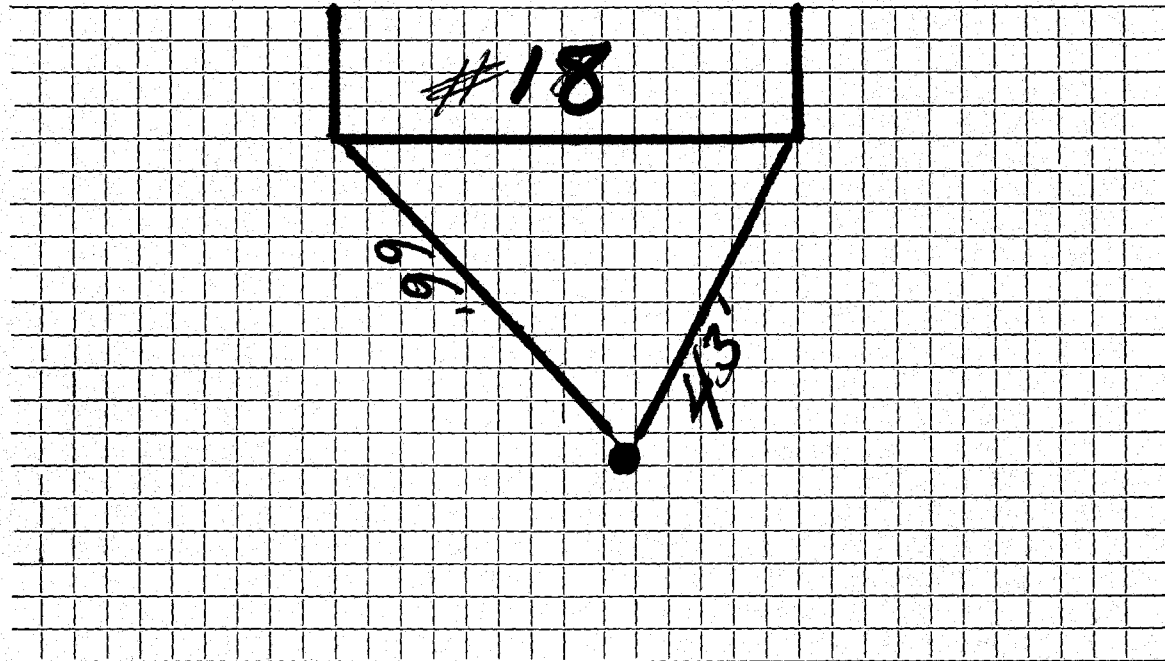

Connection made in Street. Work completed

Remarks:
.....
.....