

WATER SERVICE RECORD

#1725

Name Leeland Const. Co.

Service No. 114

Address 19 Oxbow Road

Location

~~Repair~~ ~~Renewal~~ New Service


Comm 8-22-60

Date	Material	Amount	Total	Date	Amount
7-11-60	Labor	2 05		7-7-60	Deposit 50 00
	10% O.H.	21	2 26	5-22-60	Refund 26 51
35'	3/4" Copper tubing @42		14 70		23 13
1	3/4" Cx 1/2 I.W.H. Stop&Waste		6 17		<u>NON CHARGE</u>
			23 13	8-5-59	Labor 1 85
					21' 3/4" Copper tubing @.38 7 98
					1 3/4" C Corp Cock 4 67
					1 3/4" C Curb Cock 6 07
					1 Box & Rod 5 00
					1 Hr. Trucking 75
					<u>26 32</u>
					1 1/8 Straight tailpiece 50
					1 1/8 Offset tailpiece 50
					<u>27 32</u>

TOWN OF LEXINGTON — BOARD OF PUBLIC WORKS

WATER DIVISION

Sketch of Service Here

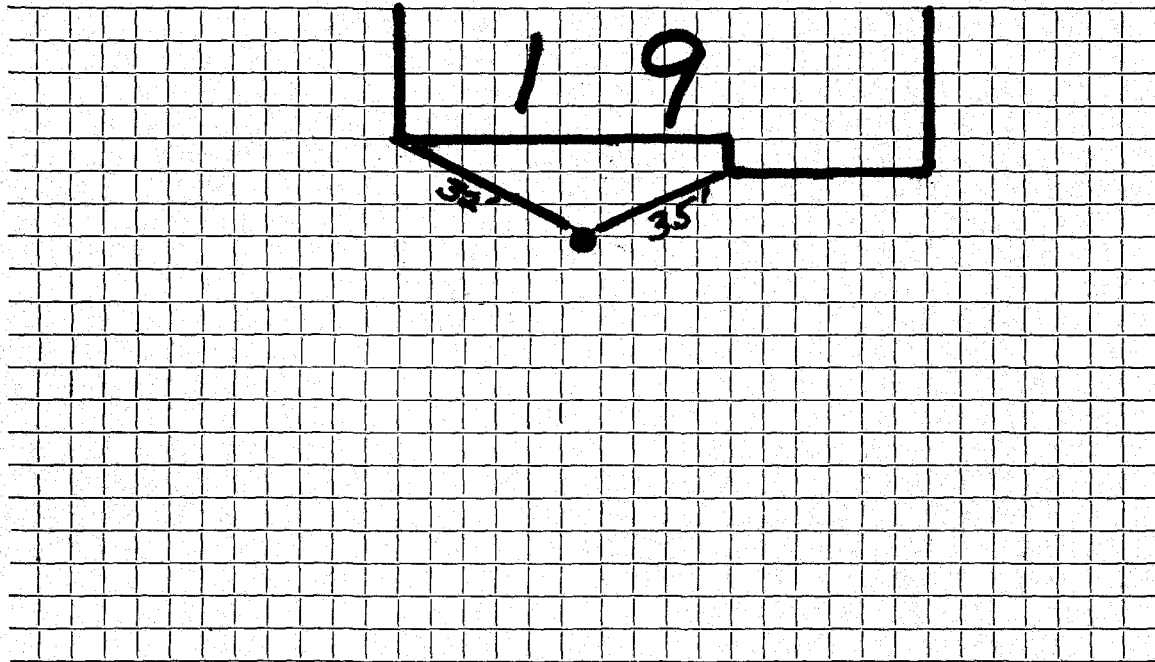

Connection made in Street. Work completed

Remarks:

.....
.....