

WATER SERVICE RECORD

1193

Name Vern Clark

Service No. 105

Address 2 Oxbow Road

Location Lexington

~~Rough~~ ~~Home~~ - New Service

P.m. 7-28-52


Date	Material	Amount	Total	Date	Amount
6/28/52	Labor	9 42		6-4-52 Deposited 7-28-52 Refunded	25 00 (9 66)
	10% Overhead	94	10 36		<u>NON CHARGE</u> 65 34
	80' - 3/4" Copper tubing@.3439	27 51		6/28/52 Labor	9 42
	1 - 3/4" C x 1/2 I.W.H. Stop & Waste	4 00		15' - 3/4" Copper tubing@.3439	5 16
	1 - 3/4" C x 3/4" C. Union	3 pts 1 72		1 - 3/4" C. Corp-Cock	4 33
	3 hrs. Littlefield Shovel	21 00		1 - 3/4" C x 3/4" C. Curb-cock	4 67
	1 hr. trucking		75	1 Box and Rod	4 52
			65 34	1 - 1/2 offset tail piece	50
				1 - 1/2 straight tail piece	50
				1 hr. Littlefield Shovel	7 00
				1 hr. trucking	75
					<u>36 85</u>

DATE _____

TOWN OF LEXINGTON — BOARD OF PUBLIC WORKS

WATER DIVISION

Sketch of Service Here

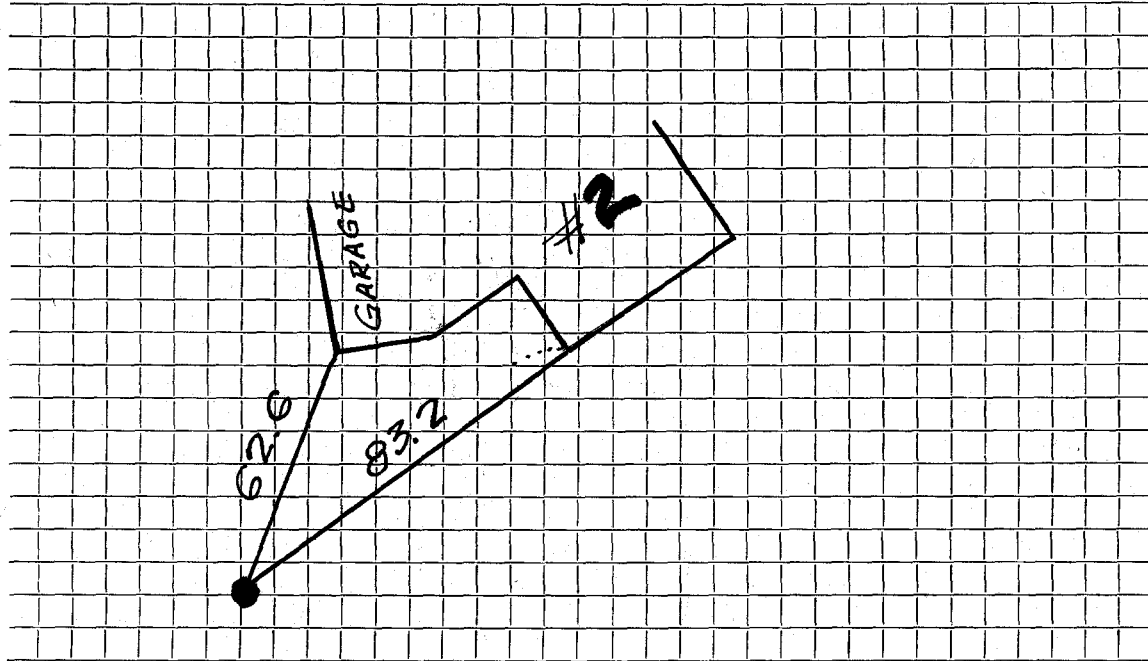

Connection made in Street. Work completed

Remarks:

.....

.....