

## WATER SERVICE RECORD

#6047

Name Leeland Construction

Service No. 255

Address 20 Oxbow Road

Location


~~Repair - Extension~~ New Service

Comm 12-31-59

Date	Material	Amount	Total	Date	Amount	
11-5-59	Labor	1 85		10-14-59	Deposit	50 00
	10% O.H.	19		12-31-59	Retained	23 52
			2 04			26 48
	37' 3/4" Copper Tubing @.42	15 54			<u>NON CHARGE</u>	
	1 3/4" Cx 1/2 IWH Stop & Waste	5 88		29'	3/4" Copper tubing	
	1 hr. trucking @ .75	75			@1.50/ft.	43 50
	1 3/4" C3 part Union	2 27		1	3/4" C Corp Cock	4 67
		26 48		1	3/4" C Curb Cock	6 07
				1	Box & Rod	5 00
						61 84
					1 1/2 Offset tail piece	50
					1 1/2 Straight tail piece	50
						62 84

TOWN OF LEXINGTON — BOARD OF PUBLIC WORKS  
WATER DIVISION

Sketch of Service Here

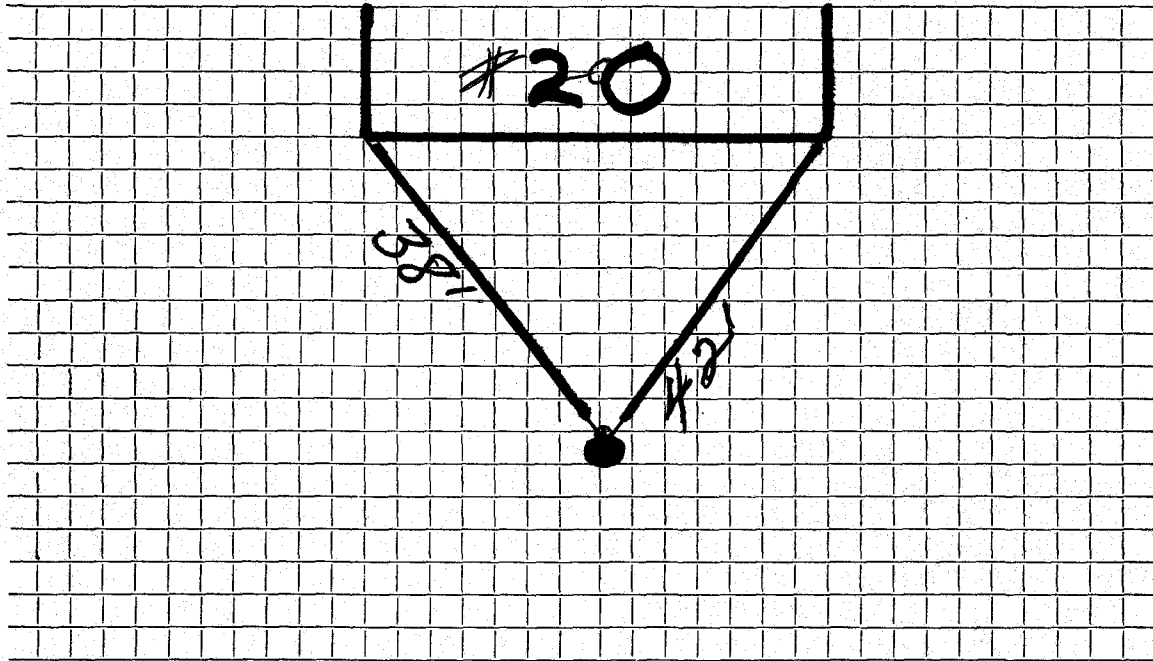

Connection made in ..... Street. Work completed .....

Remarks: .....  
.....  
.....