

WATER SERVICE RECORD

2874

Name Leeland Const. Co.

Service No. 115

Address 21 Oxbow Road

Location

~~REPAIR WORK~~ - New Service

Comm 8-22-60


Date	Material	Amount	Total	Date	Amount
7-11-60	Labor	1 75		7-7-60	50 00
	10% O.H.	18	1 93	8-20-60	19 87
35'	3/4" Copper tubing @42		14 70		30 11
1	3/4" Cx 1/2 I.W.H. Stop&Waste		6 17		<u>NON CHARGE</u>
1	Box & Rod		4 90	8-5-59	Labor 1 85
1	3/4" C3 part Union		2 41	20'	3/4" Copper tubing @.3 7 60
			30 11	1	3/4" C Corp Cock 4 67
				1	3/4" C Curb Cock 6 07
				1	Box & Rod 5 00
				1	Hr. Trucking 75
					<u>25 94</u>
				1	1/2 Straight tailpiece 50
				1	1/2 Offset tailpiece 50
					<u>26 94</u>

DATE _____

TOWN OF LEXINGTON — BOARD OF PUBLIC WORKS

WATER DIVISION

Sketch of Service Here

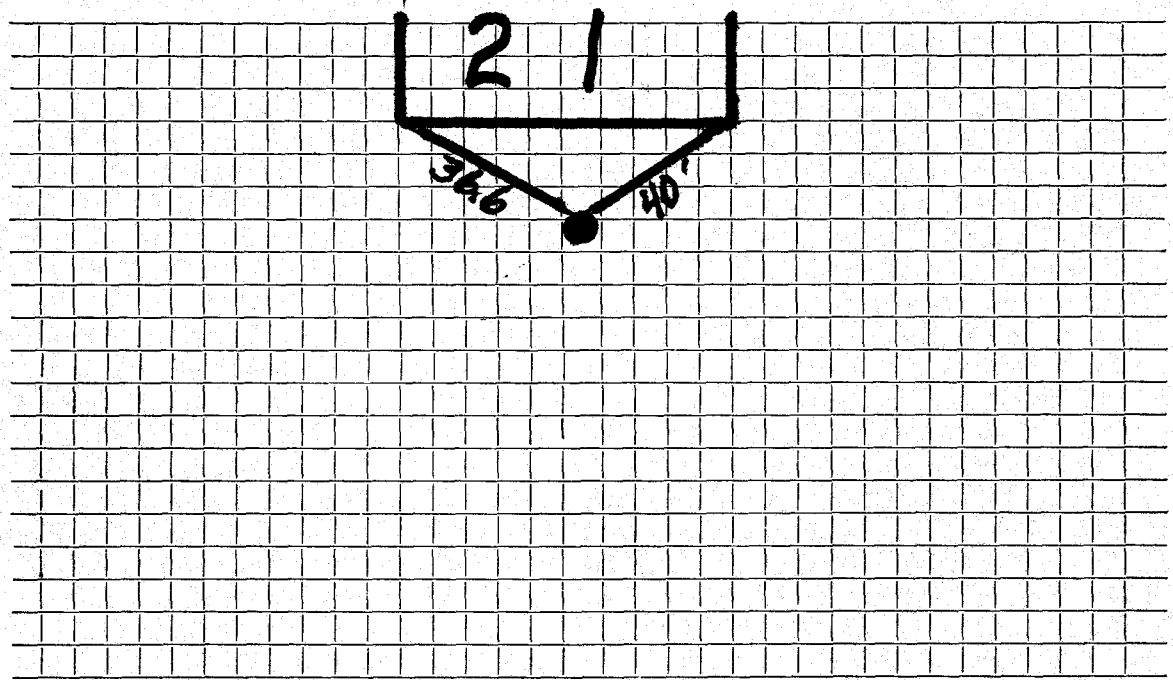

Connection made in Street. Work completed

Remarks:
.....
.....