

WATER SERVICE RECORD

Name Leeland Const. Co.

Service No. 256

Address 22 Oxbow Road

Location

~~Repair~~ ~~Renewal~~ New Service


Comm 12-31-59

Date	Material	Amount	Total	Date	Amount
8-4-59	Labor	1 85		10-14-59	Deposit 50 00
	10% O. H.	19	2 04	12-31-59	Retained 11 12
16'	3/4" Copper tubing @.38		6 08		38 82
1	Hr. Trucking		75		<u>NON CHARGE</u>
			8 87	8-1-59	Labor 1 85
	BILL WHEN CONNECTED			24'	3/4" Copper tubing @.38 9 12
11-5-59	Labor	1.95		1	3/4" C Corp Cock 4 67
	10% o.H.	.20	2.15	1	3/4" C Curb Cock 6 07
45'	3/4" Copper tubing @.42		18.90	1	Box & Rod 5 00
1	3/4" C x 1/2 I.W.H. Stop & Waste		5.88		<u>26 71</u>
1	3/4" C 3 part union		2.27		
1	hr. Trucking @.75		.75		
			<u>38.82</u>		

TOWN OF LEXINGTON — BOARD OF PUBLIC WORKS

**WATER DIVISION**

Sketch of Service Here

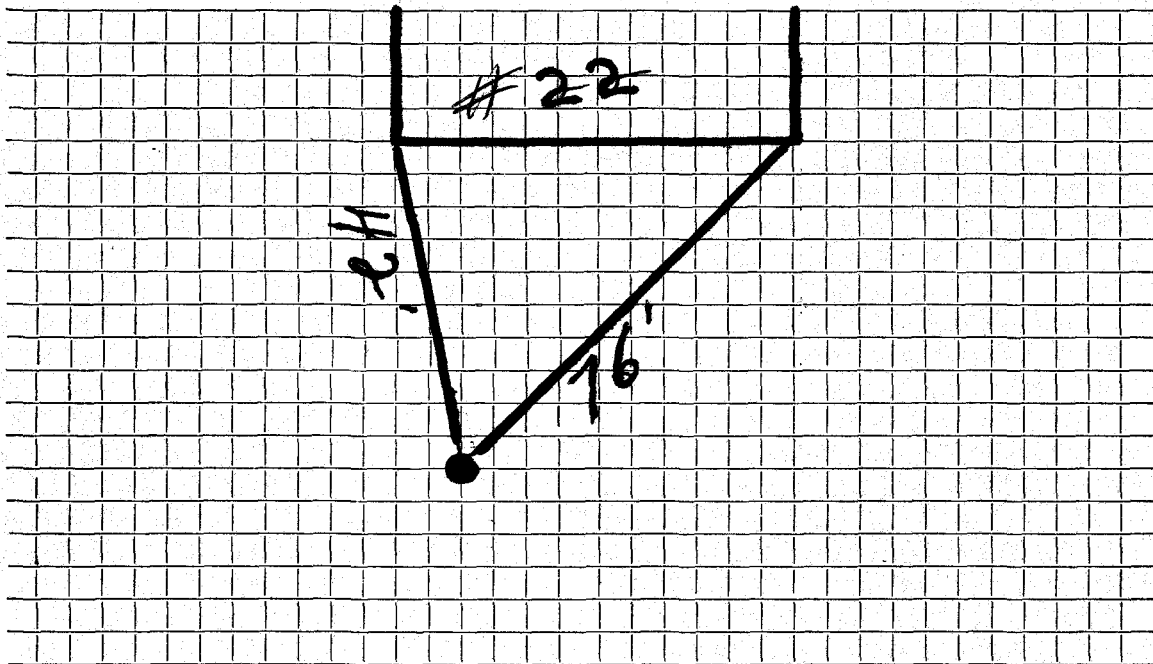

Connection made in ..... Street. Work completed .....

Remarks: .....

.....  
.....