

WATER SERVICE RECORD

#185

Name Leeland Const. Co.

Service No. 90

Address 23 Oxbow Road

Location

~~Repair - Renewal~~ - New Service

Comm 8-22-60


Date	Material	Amount	Total	Date	Amount
7-12-60	Labor	2 11		6-9-60	50 00
	10% O.H.	21	2 32	2-22-61	25 24
33'	3/4" Copper tubing @42		13 86		24 76
1	3/4" Cx $\frac{1}{2}$ I.W.H. Stop&Waste		6 17		<u>NON CHARGE</u>
1	3/4" C3 part Union		2 41	8-5-59	Labor 1 85
			24 76		26' 3/4" Copper tubing @.38 9 88
					1 3/4" C Corp Cock 1 67
					1 3/4" C Curb Cock 6 07
					1 Box & Rod 5 00
					1 Hr. Trucking <u>75</u>
					28 22
					1 $\frac{1}{2}$ Straight tailpiece 50
					1 $\frac{1}{2}$ Offset tailpiece 50
					<u>29 22</u>

DATE _____

TOWN OF LEXINGTON — BOARD OF PUBLIC WORKS

WATER DIVISION

Sketch of Service Here

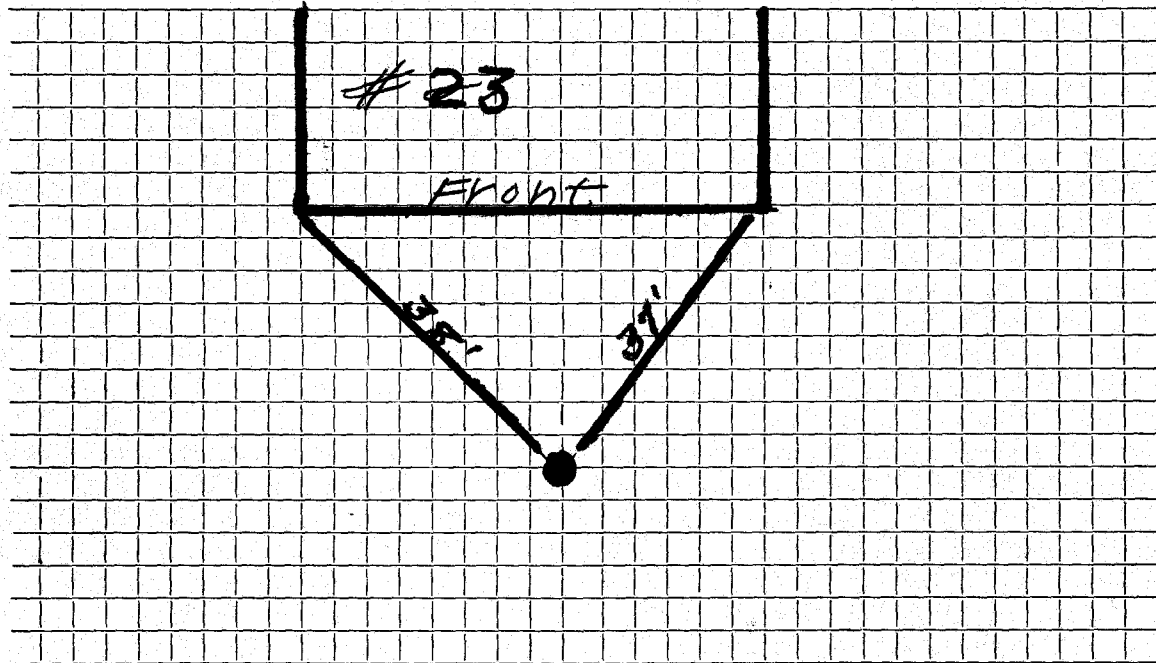

Connection made in Street. Work completed

Remarks:

.....

.....