

## WATER SERVICE RECORD

Name Leeland Construction Co.

Service No. 334

Address 24 Oxbow Road

Location

# 691

~~REPAIR~~ ~~REPAIR~~ New Service


Comm 2-29-60

Date	Material	Amount	Total	Date	Amount	
7-31-59	Labor	1 85		12-24-59	Deposit	50 00
	10% O. H.	19	2 04	2-29-60	Retained	12 15
	16' 3/4" Copper tubing @.38		6 08			37 87
	1 Hr. Trucking		75		<u>NON CHARGE</u>	
			8 87	7-31-59	Labor	1 85
	BILL WHEN CONNECTED				24' 3/4" Copper tubing @.38	9 12
2-9-60	Labor	1 85			1 3/4" C Corp Cock	4 67
	10% O.H.	19	2 04		1 3/4" C Curb Cock	6 07
	42' 3/4" Copper tubing @.42		18.06		1 Box & Rod	5 00
	1 3/4" Cx 1/2 I.W.H. Stop&Waste		5.88			26 71
	1 3/4" C3 Part Union		2.27	2-9-60	1 1/2 Straight tailpiece	50
	1 Hr. Trucking @.75		75		1 1/2 Offset tailpiece	50
			37.80			27.71

TOWN OF LEXINGTON — BOARD OF PUBLIC WORKS

WATER DIVISION

Sketch of Service Here

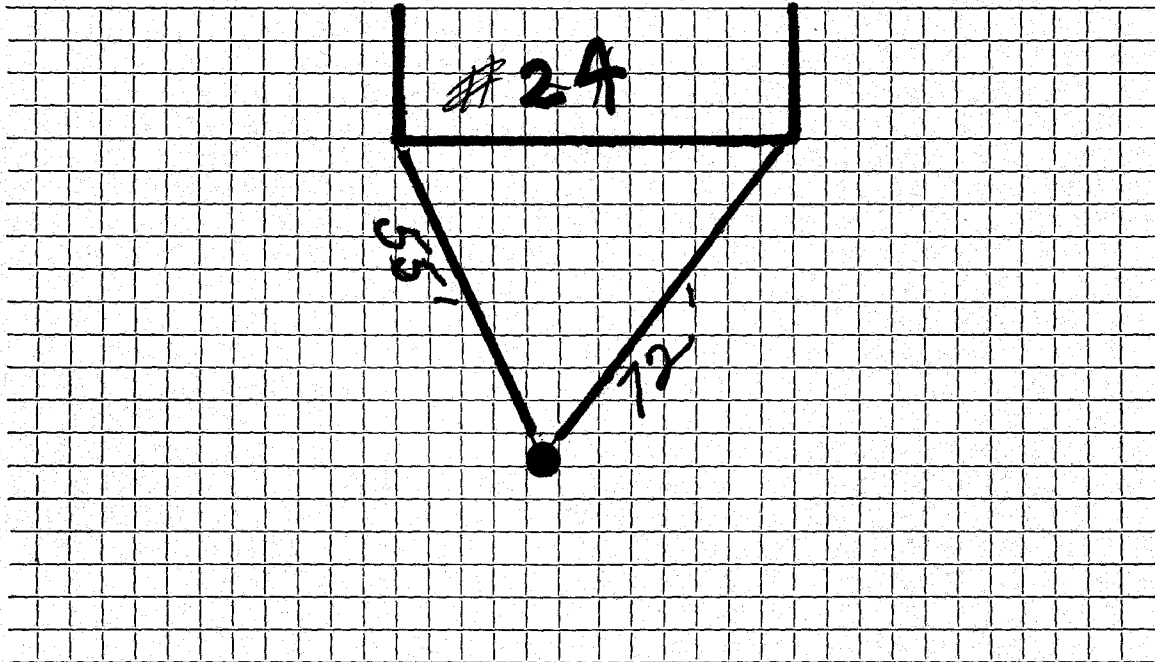

Connection made in ..... Street. Work completed .....

Remarks: .....  
.....  
.....