


TOWN OF LEXINGTON - BOARD OF PUBLIC WORKS
WATER DIVISION

Date: 4/30/21

SKETCH OF SERVICE HERE

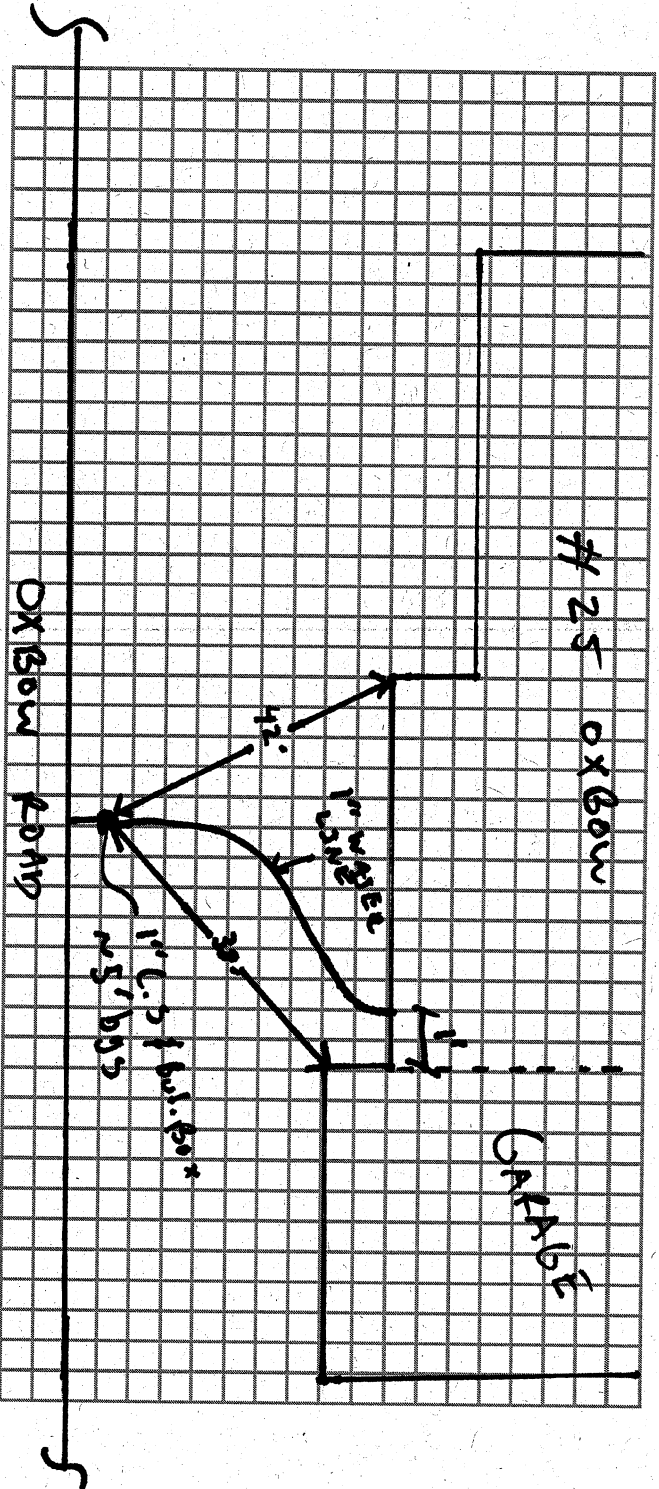

Connection made in: OX Bow

Remarks:

Renewal

Street:

Work completed:

WATER SERVICE RECORD

4546

Name Leeland Const.

Service No. 74

Address 25 Oxbow Road

Location

~~Repair~~ ~~Renewal~~ - New Service


Comm 7-5-60

Date	Material	Amount	Total	Date		Amount
6-1-60	Labor	1.94		5-24-60	Deposit	50.00
	10% O.H.	.19	2.13	7-5-60	Retard	17.38
	46' 3/4" Copper tubing @.12		19.32			32.62
	1 3/4" C x 1/2 I.W.H. Stop & Waste		6.17		<u>NON CHARGE</u>	
	1 Curb Box & Rod		5.00	8-4-59	Labor	1.85
			32.62		16' 3/4" Copper tubing @.38	6.08
					1 3/4" C Corp Cock	4.67
					1 3/4" C Curb Cock	6.07
					1 Box & Rod	5.00
					1 Hr. Trucking @.75	75
						24.47
					1 1/2 Straight tailpiece	.50
					1 1/2 Offset tailpiece	.50
						25.42

DATE _____

TOWN OF LEXINGTON — BOARD OF PUBLIC WORKS
WATER DIVISION

Sketch of Service Here

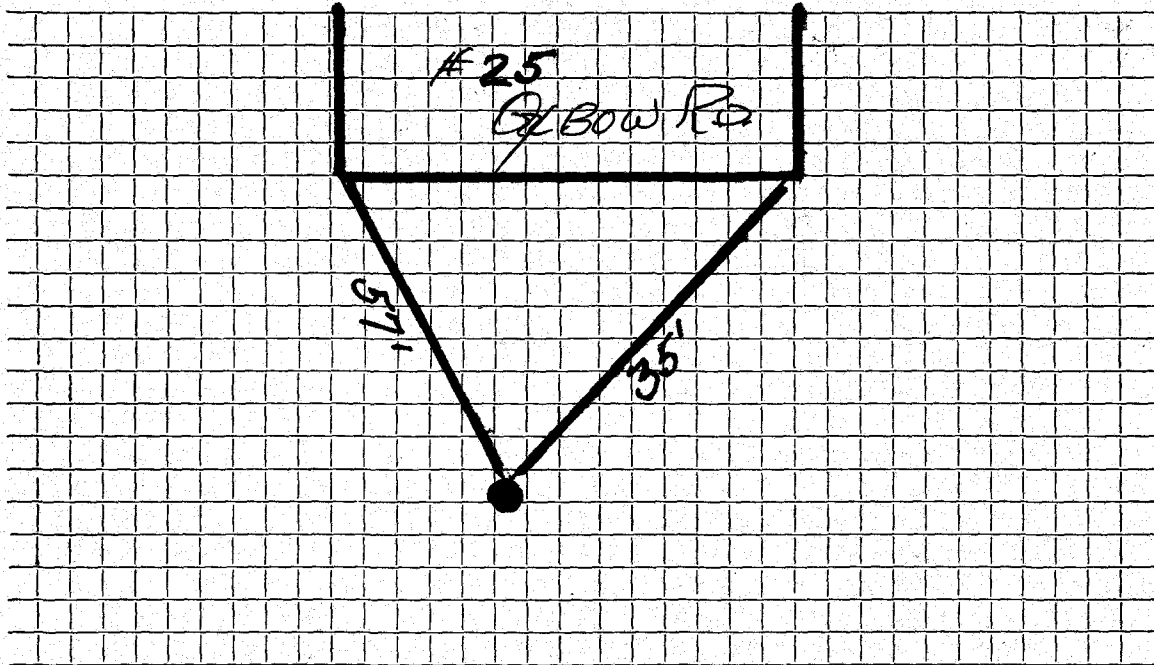

Connection made in Street. Work completed

Remarks:

.....

.....