

## WATER SERVICE RECORD

# 357

Name Leeland Construction Co.

Service No. 2

Address 26 Oxbow Road

Location

~~Repair~~ ~~Renewal~~ New Service


Comm 2-29-60

Date	Material	Amount	Total	Date	Amount
7-31-59	Labor	1 85		2-4-60	Deposit 50 00
	10% O. H.	19	2 04	2-29-60	Refund 10 76
	1 1/4" 3/4" Copper tubing @.38		5 32		39 24
	1 3/4" C 3 part Union		2 30		<u>NON CHARGE</u>
	1 Hr. Trucking		75	7-31-59	Labor 1 85
			10 41	27'	3/4" Copper tubing @.38 10 26
	BILL WHEN CONNECTED			1	3/4" C Corp Cock 4 67
2-9-60	Labor	1.85		1	3/4" C Curb Cock 6 07
	10% O.H.	.19	2.04	1	Box & Rod 5 00
	48' 3/4" Copper tubing @.42		20.16		27 85
	1 3/4" C x 1/2 I.W.H. Stop & Waste		5.88	2-9-60	1 1/2 Straight tailpiece .50
	1 Hr. Trucking @.75		.75	1	1/2 Offset tailpiece .50
			39.24		28.85

TOWN OF LEXINGTON — BOARD OF PUBLIC WORKS

**WATER DIVISION**

Sketch of Service Here

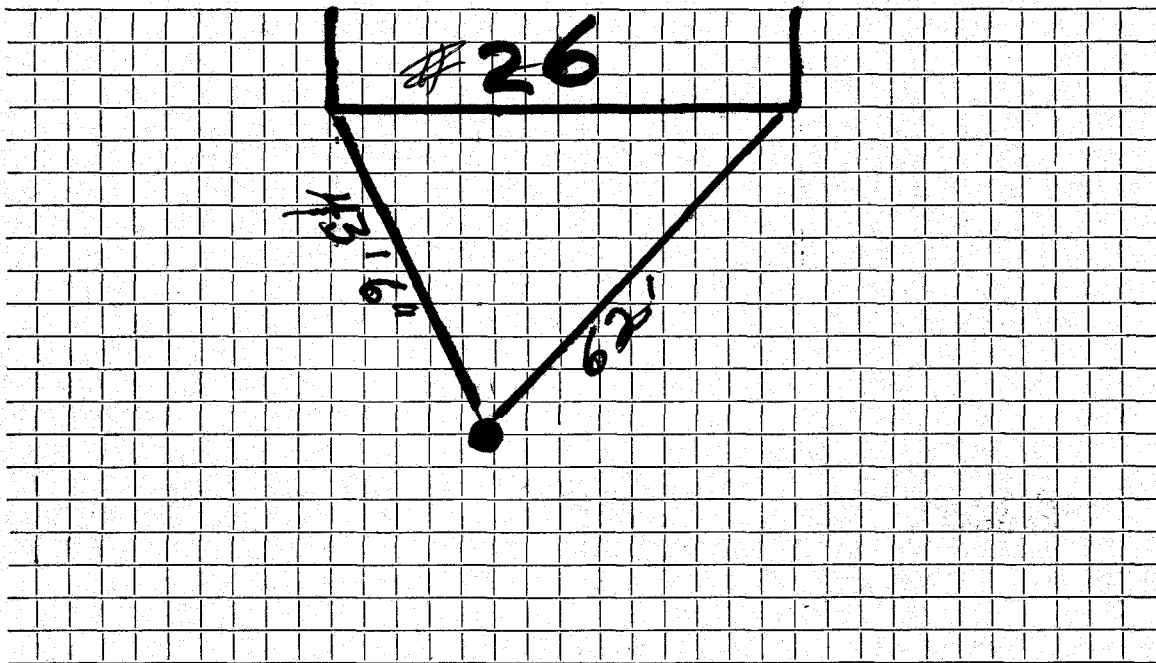

Connection made in ..... Street.                      Work completed .....

Remarks: .....  
.....  
.....