

WATER SERVICE RECORD

3215

Name Leeland Const. Co.

Service No. 91

Address 28 Oxbow Road

Location

~~Repair~~ ~~Renovate~~ New Service


Comm 8-22-60

Date	Material	Amount	Total	Date	Amount
7-31-58	Labor	1 85		6-9-60	50 00
	10% O. H.	19	2 04	8-22-60	16 68
	14' 3/4" Copper tubing @.38		5 32		33 32
	1 Hr. Trucking		75		
			8 11		
				7-31-59	
	BILL WHEN CONNECTED			Labor	1 85
				28' 3/4" Copper tubing @.38	10 64
7-11-60	Labor	1 75		1 3/4" C Corp Cock	4 67
	10% O.H.	18	1 93	1 3/4" C Curb Cock	6 07
	35' 3/4" Copper tubing @.42		14 70	1 Box & Rod	5 00
	1 3/4" Cx 1/2 I.W.H. Stop&Waste		6 17		28 23
	1 3/4" C3 part Union		2 41	1 1/2 Straight tailpiece	50
			33 32	1 1/2 Offset tailpiece	50
					29 23

TOWN OF LEXINGTON — BOARD OF PUBLIC WORKS

WATER DIVISION

Sketch of Service Here

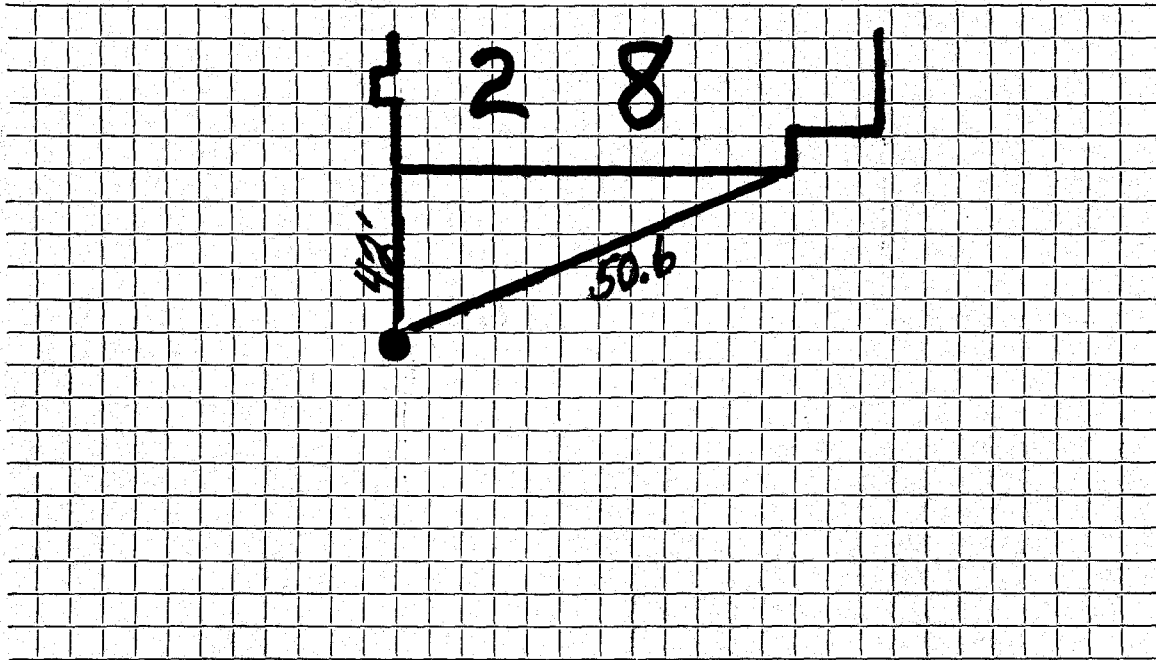

Connection made in Street. Work completed

Remarks:
.....
.....